

Barton

KANSAS

DX 78-1

Section 22 Township 19 Range 13W

Well No. #1 Esfeld "B"

Company Honaker Drlg / 3

NORTH

0							

WEST

EAST

SOUTH

Barton KANSAS

SEC. 22 TWP. 19 R. 13W ✓


WELL NO. 1 Esfeld "B" FARM

COMPANY Honaker Drlg.

CONTRACTOR Honaker Drlg.

Gt. Bend Townsite Pool

_____ Ft. from N. Line
 330 _____ Ft. from S. Line
 _____ Ft. from E. Line
 330 _____ Ft. from W. Line

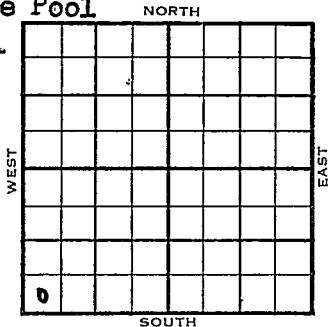

SW SW SW

1954 ELEVATION 1847' REPORT

- 5/5 Spud 5-2-54
8" @ 743', WOC
- 5/12 Anhy 733'
Drlg. 2815'
- 5/19 Heeb 3047', Br. L. 3146', Lans 3157'
DST 3218'-32' 1 hr, 2580' gassy oil
120' Wtr, 1040#
Cong 3383', Arb 3440'
TD 3444'
5" @ 3444'
- 5/26 WOCT
- 6/2 CO 3430', 20/3227-31½, 250' oil,
FU 2590' oil 1½ hrs., 500A
F&S 26½ boph & trace
S 46 BO 1 hrs.
- 6/9 NR
- 7/14 Spud 5-2-54 - Oil Well
TD 3444'
8" @ 743'
Anhy 733', Heeb 3047', Br line 3146',
Lans 3157'
DST 3218-32', opn 1 hr., rec. 2580'
gassy oil, 120' wtr, 1040#
Cong 3383', Arb. 3440'
TD 3444'

(Information Brought Forward)

1954

7/14

5" @ 3444'

CO to 3430'

20/3227-31

FU 250' oil

FU 2590' oil $1\frac{1}{2}$ hrs., 500A

F&S $26\frac{1}{2}$ boph

F 46 bo 1 hr.

Comp. 136 bopd

COMPLETED

County Barton State Kansas

Sec. 22 (Blk. 19 (Sur. 13W Map No. (Twp.) (Rge.))

Operator Honaker Drlg.

Well No. 1 Farm Esfeld "B"

Elev. 1847 Location SW SW SW

330 Ft. From S Line SW

330 Ft. From W Line Quarter

1st. Report

Completion JUL 14 1954

Remarks Gt. Bend Townsite Pool

Honaker Drlg. - Contr.

Spudding Date 5-2-54

Drlg. Data Oil well TD 3444

8" @ 743 Anhy 733 Heeb. 3047

Br. lime 3146 Lans. 3157 DST 3218-32

open 1 hr. Rec. 2580' gassy oil 120' wtr.

1040# Cong. 3383 Arb. 3440 TD 3444

5" @ 3444 CO to 3430 20/ 3227-31

FU 250' oil, FU 2590' oil 1 1/2 hr. 500 A

F & S 26 1/2 boph F/ 46 bo 1 hr.

Comp. 136 bopd