


Section 28 Township 19 Range 13 W

Well No. # 1 Haberman

Company Honaker Drlg.

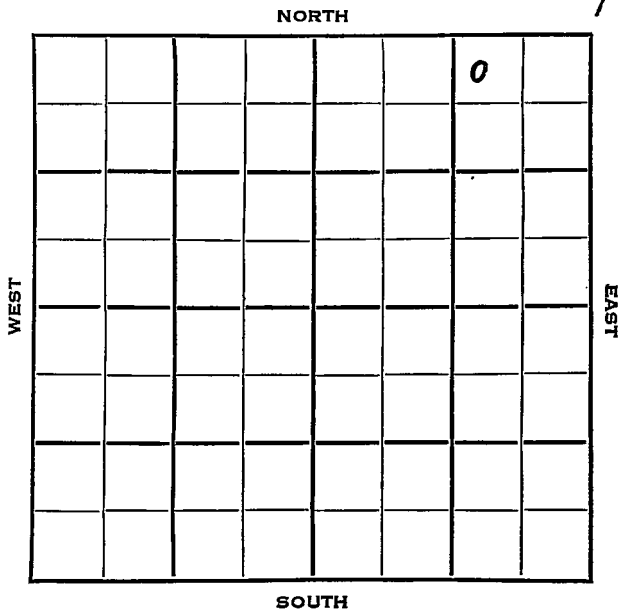

Barton


KANSAS

SEC.	TWP.	R.
28	19	13W ✓

WELL NO. _____
 COMPANY 1 Haberman FARM

CONTRACTOR Honaker Drlg.

330 _____ Ft. from N. Line
 _____ Ft. from S. Line
1090 _____ Ft. from E. Line
 _____ Ft. from W. Line

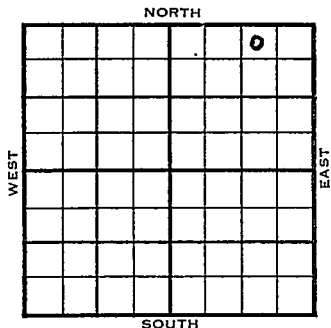

NW NE NE
 TITE HOLE

1953	ELEVATION	REPORT
	1846'	

9/30 Spud 9-25-53
 Surface Set

10/7 Drlg.

10/14 NR

10/28 "

11/4 "

11/11 "

11/18 "

12/9 Spud 9-25-53 Oil well TD 3490
 Arb. 2444 Perf 3444-48 250 A
 TD 3490 5" @ 3490 S/72 BO 6 hr.
 Comp. 235 BOPD 10% wtr.

COMPLETED

