

Map No.

Well No.

KANSAS

Sec.

Twp.

R.

Farm

Company

NORTH

WEST

EAST

SOUTH

Location

Drilling Remarks

Rig Up

Drilling Remarks

RECORD

Cased in ft.

Sand

Gas

Oil

Total Depth

PRODUCTION

1st 24 hrs. Nat.

1st 24 hrs. after shot

Gas cu. ft.

Dry Hole

Abandoned

Woodson

Map No. KANSAS Sec. 34 Twp. 25 R. 14E

Well No. 1-B Hassempflug (K6504) Farm


Saco oil Company

990 Ft. from N. Line

_____ Ft. from S. Line

_____ Ft. from E. Line

330 Ft. from W. Line

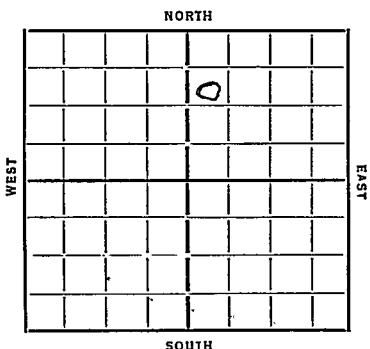

Date
1935

REPORT

8/7 Drilling 100'
8/15 " 400
8/22 " 650
8/29 " 930
9/6 " 1340
9/20 Laid 1465-1509
 T 7 1509
 100 gals 150 Blw.

COMPLETED

Map No. 17 Sec. 34 Twp. 25 R. 14EWell No. B HassempfingLuco oil Company

Contractor

FIRST REPORTS

SECTION PLAT

990 Ft. from N. Line

Ft. from S. Line

Ft. from E. Line

330 Ft. from W. Line

		0	

Location

Rig up

Drilling and Remarks:

leg 100'

RECORD

Cased in., ft.

Sand

Gas

Oil

Total Depth

PRODUCTION

1st 24 hrs. Nat.

1st 24 hrs. after shot

Gas Cu. Ft.

Dry Hole

Abandoned

Date

8-7-35

192

MANN SCHRECK

Scout

Map No. 17 Sec. 34 Twp. 25 R. 14 EWell No. 1-B HassenpflugSaco Oil CompanyKANSAS Contractor**COMPLETED**

SECTION PLAT

		0	

Location.....

Rig up.....

Drilling and Remarks:

100 gts150 lbs

RECORD

Cased.....in.....ft.

Sand. 1465-1509

Gas.....

Oil.....

Total Depth 1509

PRODUCTION

1st 24 hrs. Nat.....

1st 24 hrs. after shot.....

Gas.....Cu. Ft.

Dry Hole.....

Abandoned.....

Date

9-20-35 192 Scout