


Section 15 Township 19 Range 14W **KANSAS**

Well No. #1 Warnkon

Company Ben Brack

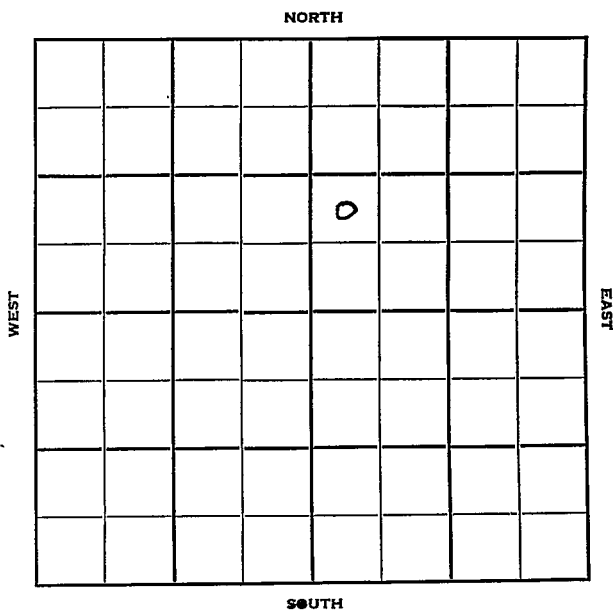

Sec. 15 Twp. 19 R. 14W

Well No. #1 Warnkon Farm

Ben Brock Company

Ben Brock - Contr. Contractor
Alefs


 Ft. from N. Line

990' Ft. from S. Line

 Ft. from E. Line

330' Ft. from W. Line

NW SW NE

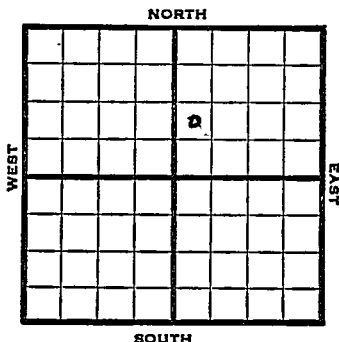

1952 Elev. 1815' REPORT

- 7/2 Spud 6-30-52
8" @ 840
WOC
- 7/9 Anhy 838'
Drlg. 2715'
- 7/17 Br li 3220' Lans. 3233' Cong 3469'
Arb. 3571' RTD 3585' 5" @ 3485'
- 7/23 12/3392-96 500 A HFW & SSO
PB 3380 Perf ?/ 3358-66 HFW
drove plug to btm. PB 3385
- 7/30 22/3359-66 HFW sq. off
Re perf 3359-66'
- 8/6 NR
- 8/13 "
- 8/20 500 A 2 Boph 1000 A 1/2 boph &
trace wtr Set plug 3330
19/3287-93 500 A trace wtr sq off
DC 3385 2500 A 3359-66 2 boph
- 8/27 S/ 3 Boph
- 9/3 NR
- 9/10 P. 70 BOPDd
- 9/17 Spud 6-30-52 Oil Well TD 3585'
8" @ 3233' Cong 3469' Br-Li 3220
Lans. 3233 Cong. 3469
Arb. 3571 TD 3585'
HFW & SSO PB 3380 Perf ?/ 3358-66
HFW PB 3385 3220' 3359-66 HFW.
Comp. 244 bopd 25. wtr.

OVER

1952

9/17

Reperf 3359-66 500 A 2 boph
1000 A $\frac{1}{2}$ boph SP 3330 19/ 3287-93
500 A tr. wtr. DP 3385 2500 A
2 boph S/ 3 boph P/ 70 bopd
Comp. 26 bopd 26% wtr.

COMPLETED

