


Butler

KANSAS

Section 11 Township 28 Range 7-E

Well No. 1 Burnham


Company Republic Nat

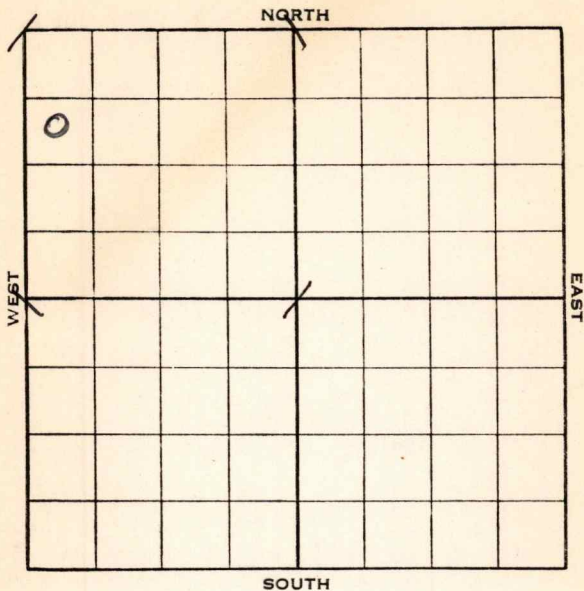

Sec. 11 Twp. 28 R. 7-E

Well No. #1 Burnham Farm  
Republic Nat'l. Company

990 Ft. from N. Line  
 \_\_\_\_\_ Ft. from S. Line  
 \_\_\_\_\_ Ft. from E. Line  
330 Ft. from W. Line

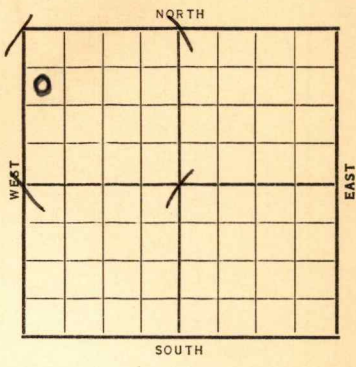

**Elev. 1480**

Date	REPORT
1938	
7/27	S. H. (Roty Rig)
8/5	10" - 40'. Dlg. 1700'.
8/12	<b>Miss. 2784'. Reaming.</b>
8/17	<b>Arb. 3228'.</b>
	T. D. 3232'.
	S. S. Oil & H. F. W.
	<b>ABANDONED</b>

Map No. 10 Sec. 11 Twp. 28 R. 7E

Well No. 1 Burnham

Republic Nat. Company

Contractor

FIRST REPORT

SW NW NW

SECTION PLAT

0			

990 Ft. from N. Line

\_\_\_\_\_ Ft. from S. Line

\_\_\_\_\_ Ft. from E. Line

330 Ft. from W. Line

Location \_\_\_\_\_

Rig up \_\_\_\_\_

Drilling and Remarks:

SH (Roty Rig)

RECORD

Cased \_\_\_\_\_ in., \_\_\_\_\_ ft.

Sand \_\_\_\_\_

Gas \_\_\_\_\_

Oil \_\_\_\_\_

Total Depth \_\_\_\_\_

PRODUCTION

1st 24 hrs. Nat. \_\_\_\_\_

1st 24 hrs. after shot \_\_\_\_\_

Gas \_\_\_\_\_ Cu. Ft.

Dry Hole \_\_\_\_\_

Abandoned \_\_\_\_\_

Date

JUL 27 1938 19 H. D. Hatfield Scout

Map No. 10 Sec. 11 Twp. 28 R. 7E

Well No. 1 Burnham

Republic Natural

Company

Contractor

ABANDONED

SECTION PLAT

SW NW NW

990 Ft. from N. Line

\_\_\_\_\_ Ft. from S. Line

\_\_\_\_\_ Ft. from E. Line

330 Ft. from W. Line

0			

Location \_\_\_\_\_

Rig up \_\_\_\_\_

Drilling and Remarks:

*SSO & HFW*

*DVA*

RECORD

Cased \_\_\_\_\_ in., \_\_\_\_\_ ft.

Sand *Atb 3228*

Gas \_\_\_\_\_

Oil \_\_\_\_\_

Total Depth *3232*

PRODUCTION

1st 24 hrs. Nat. \_\_\_\_\_

1st 24 hrs. after shot \_\_\_\_\_

Gas \_\_\_\_\_ Cu. Ft.

Dry Hole \_\_\_\_\_

Abandoned \_\_\_\_\_

Date

AUG 17 1938 19

H. D. Hatfield Scout