


Section 19 Township 19 Range 13 WWell No. #1 WallaceCompany Honaker Drilg. + Amerada

NORTH

WEST

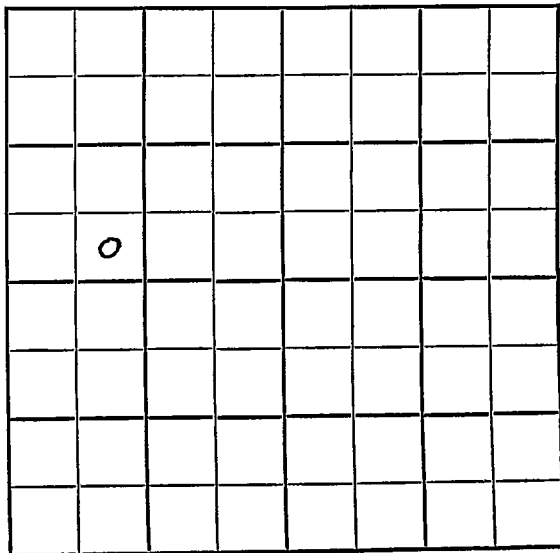

EAST

SOUTH

25

O.W.W.O.

Barton

KANSAS

SEC.

TWP.

R.

19

19

13W

WELL NO.

#1 Wallace

FARM

COMPANY

Honaker Drlg. & Amerada

CONTRACTOR

Co. Tools

WILDCAT

NORTH


_____ Ft. from N. Line

_____ Ft. from S. Line

_____ Ft. from E. Line

_____ Ft. from W. Line

SE SW NW

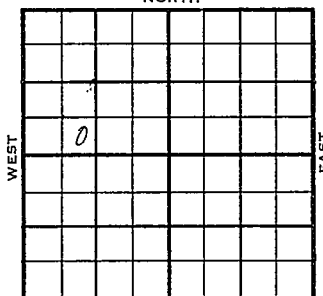

Amerada FO

1956

ELEVATION

1864

REPORT

2-22

Comm. 2-17-56

8" @ 772/400

Drlg. 1500

3-21

DST 3222-50 op 36 min. gas in 4 min.
F/ oil in 35 min, 1030#DST 3301-35 op 1 $\frac{1}{4}$ hr. gas in 8 min,
rec. 1900' oil, 1050/20"

DST 3436-41 op 20 min, rec 10' mud, 0#

DST 3436-46 op 1 hr. rec. 60' oil,
5 $\frac{1}{2}$ " @ 3481,

CO 24/ 3462-66

S/ 5 $\frac{1}{2}$ bo 2 hrs., ~~50~~ 20% wtr., 250 A

S/ 82 bo 20 % wtr. 3 hrs.,

Comp. 344 bopd, 6% wtr.

Anh. 765

BL 3162

L. 3172

A. 3434

TD 3481

COMPLETED

OVER

1956

O.W.W.O.

8-1 Old info- OTD 3481; 5" @ 3481;
Comp. Oil Well Arb 3462-66;

NEW INFO; RUCT July 16th, pull rods, set
bridge plug 3449; 15/3440-45; o/s/ B/
3/4 bfph; 250 A;
Swb 4 3/4 bfph(4 bw);
LWP 3396; 18/3335-49; tst 3 3/4 goph;
2000 A;
Swb 1d & start flo; kill well;
Swb 24 boph, no/wtr., no time; testing.
L. 3172'; A. 3434';

8-15 P/ 288 bopd, no/wtr.,
Grav. 39.

COMPLETED

County Barton Elev. _____
 Sec. 19 Twp. 19 Rge. 13W
 Company Honaker Drlg.
 FarmName Wallace No. 1

TOPS	DEPTH	LOG	DATUM	Loc. in Sec.
Anh.				SE SW NW
TP.				
H.				
Tr.				
Dg.				
Bl.				
L.				
K.C.				Geol. _____
B.K.C.				Contr. _____
Ce.				Co. tools _____
C.				Pool _____
M.				Wildcat
Mz.				
Mq.				
V.				
S.				
S.				
A.				
R.				
PE.				
G.				
T.D.				

Date Comm. 2-17-56 Amerada TO
8" @ 772/400 drlg. 1500

~~2~~

County Barton Elev. 1864
 Sec. 19 Twp. 19 Rge. 13W
 Company Honaker Drig.
 FarmName Wallace No. 1

TOPS	DEPTH	LOG	DATUM	Loc. in Sec.
Anh.	<u>765</u>			SE SW NW
TP.				
H.				
Tr.				
Dg.				
BL.	<u>3162</u>			
L.	<u>3172</u>		<u>1908</u>	Geol.
K.C.				Contr.
B.K.C.				Co. tools
Ce.				
C.				
M.				
M.				Pool
K.				Wildcat
Mz.				
Mq.				
V.				
S.				
S.				
A.	<u>3434</u>		<u>1570</u>	
R.				
Pe.				
G.				COMPLETE
T.D.	<u>3481</u>			

Date Comm. 2-17-56 MAR 21 1956
8" @ 772/400 DST 3 222-50 open 36 min.
gas in 1 min. F/ oil in 35 min.
1030# DST 3301-35 open 1 1/2 hr.
gas in 8 min. rec. 1900' oil 1050/20"
DST 3436-41 open 20 min. rec. 10' mud
0# DST 3436-46 open 1 hr. rec.
60' oil 5 1/2" @ 3481 CO 24/ 3462-66
S/ 5 1/2 bo 2 hr. 20% wtr. 250 A

OVER

O.W.W.O.

County Barton Elev. 1864 DF
Sec. 19 Twp. 19S Rge. 13W
Company Honaker & Amerada
Farm Name Wallace No. 1
OWWO

TOPS	DEPTH	LOG	DATUM	Loc. in Sec.
Anh.				SE SW NW
Tp.				
H.				
Tr.				
Dg.				
BL.				
L.	3172			Geol.
K.C.				Contr.
B.K.C.				
Ce.				
C.				
M.				
M.				Pool
K.				Gr. Bend W.
Mz.				
Me.				
V.				
S.				
S.				
A	3434			
R.				
Pe.				
G.				
T.D.				

FIRST REPORT

Date Comm. AUG 1 1956
Old info - OTD 3481; 5" 3481; comp. oil well

Arb. 3462-66

New info - RUCT July 16th, pull rods, set
bridge plug 3449; 15/3440-45; o/s/ B 3/4
bfph; 250 A; SW 4-3/4 bfph (4bw); LWP 3396;
18/3335-49; tst 3-3/4 goph; 2000 A; sw ld &
start flo; killwell; swb 24 boph no wtr.
no time; testing

13

County Barton Elev. 1864 DF
 Sec. 19 Twp. 19S Rge. 13W
 Company Honaker & Grada
 Farm Name Wallace

No. 1
0.750

TOPS	DEPTH	LOG	DATUM	Loc. in Sec.
Anb.				SE SW NW
T.P.				
H.				
Tr.				
Dg.				
Bl.				
L.	3172			Geol.
K.C.				Contr.
B.K.C.				
Ce.				
C.				
M.				Pool
M.				Gr. Bend W
K.				
Mz.				
Me.				
V.				
S.				
S.				
A.	3434			
R.				
Pe.				
G.				
TD.				

COMPLETE

Date Comm.

AUG 15 '56

Old info - OTD 3481; 5" 3481; comp. oil we.

Arb. 3462-66

New info - RUOT July 16th, pull rods, set
bridge plug 3449; 15/3440-45; o/s/ B 3/4

bfph; 250 A; sw 4-3/4 bfph (4bw); LWP 3396

18/3335-49; tst 3-3/4 goph; 2000 A; sw 1d
start flo; killwell; swb 24 boph no wtr.

no time; testing AUG 8 '56

AUG 15 '56 P. Pot.

288 Bopd no/w genc. 39°

S/ 82 bo 20% wtr. 3 hr.

Comp. 3 1/4 bopd * 6% wtr. .

R. G.

APR 2 1956