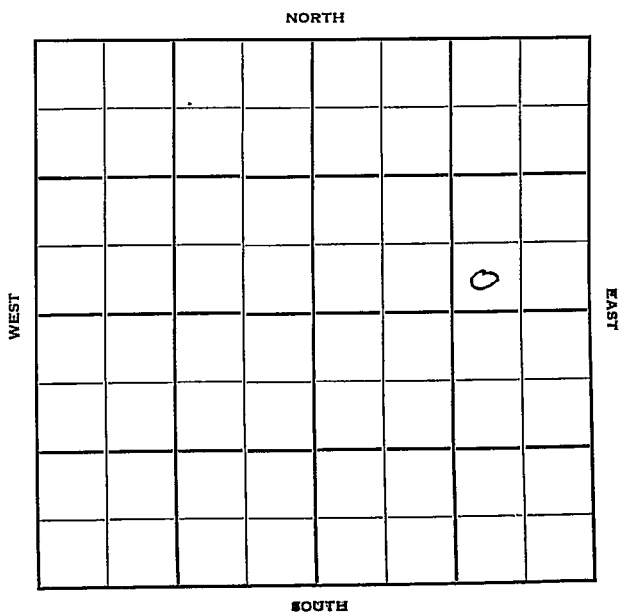


Section 34 Township 16 Range 11WWell No. #10 Frees "A"Company Elreco

Barton KANSAS

Sec. 34 Twp. 16 R. 11W

Well No. #10 Frees "A" Farm

Elreco Company

Kraft Prusa Contractor


 Ft. from N. Line

330' Ft. from S. Line

990' Ft. from E. Line

 Ft. from W. Line

SW SE NE

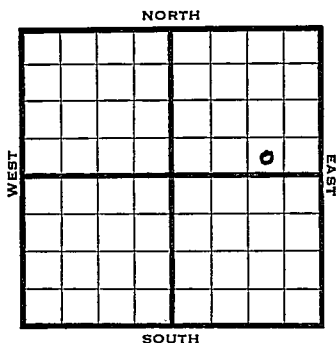

1950 Elev 1948 REPORT


8/23 Spud 8-21-50-
8" @ 320'
WOC

9/20 8" @ 320
Heeb 2997
Lans 3118
5" @ 3383
TD 3389½
S/18½ bo 2 hr
Comp 376 bopd
Completed

Br lime 3099
Arb 3382

COMPLETED

J. E. TYRA

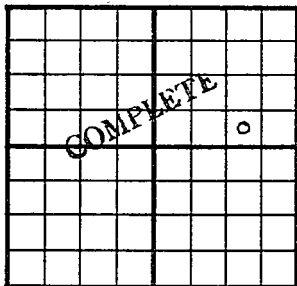County Barton State KansasSec. 34 (Blk.) 16 (Sur.) 11W Map No.Operator ElrecoWell No. 10 Farm Frees "A"Elev. 1948 Location SW SE NE330 Ft. From S Line NE990 Ft. From E Line Quarter1st. Report ~~SEP 20 1950~~Completion SEP 20 1950

Remarks

Kraft-Prusa PoolSpudding Date 8-21-50Drlg. Data Oil well TD 3389 $\frac{1}{2}$ 8" @ 320 Heeb. 2997 Br. line 3099Lans. 3118 Arb. 3382 5" @ 3383TD 3389 $\frac{1}{2}$ S/ 18 $\frac{1}{2}$ bo 2 hr.Comp. 376 bopd