


KANSAS

Butler


Section 14 Township 28 Range 7-E

Well No. 1 Ramp

Company Adair & Morton

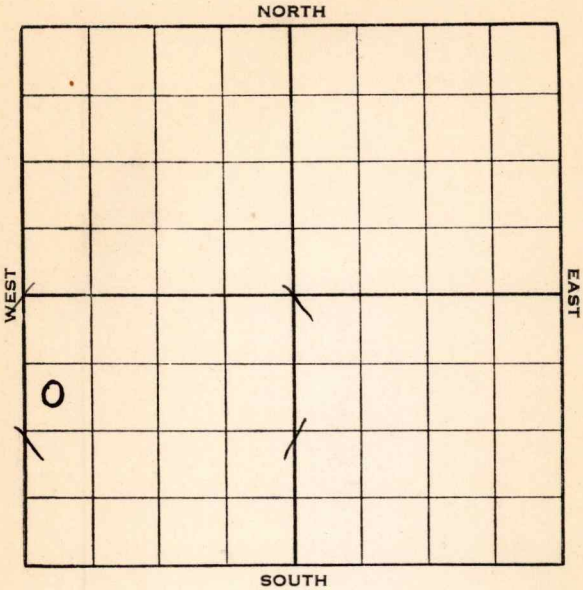

Company

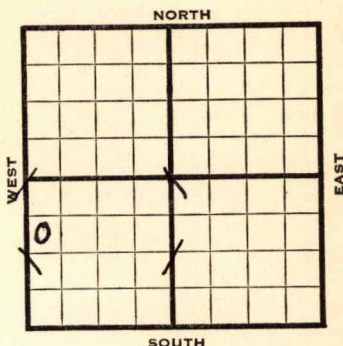

1938	REPORT
9/21	Mat'l.
9/30	R. U. Mach.
10/7	15" - 20'. Dlg. 540'.
10/14	12" - 688'. Dlg. 1335'.
10/21	10" - 1490'. 8" - 2138'.
	S. O. 2168-71'. Dlg. 2190'.
10/28	Miss. 2660'. S. O. 2669-70'.
	7" - 2670'. WOC.
11/4	T. D. 2691'. 4000 acid.
11/9	7" at 2670'.
	Miss. 2660'.
	T. D. 2691'.
	4000 acid.
	80 bbls. oil. Show water.
	COMPLETED

Map No. 10 Sec. 14 Twp. 28 R. 7EWell No. 1 RampAdair & Morton

Company


Contractor

FIRST REPORT

SW NW SW

990 Ft. from N. Line Ft. from S. Line Ft. from E. Line330 Ft. from W. Line

SECTION PLAT

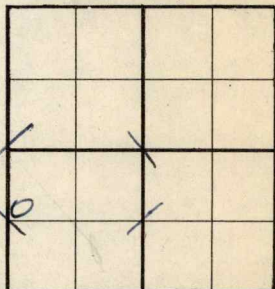Location Rig up

Drilling and Remarks:

Matl.

RECORD

Cased in., ft.Sand Gas Oil Total Depth

PRODUCTION

1st 24 hrs. Nat. 1st 24 hrs. after shot Gas Cu. Ft.Dry Hole Abandoned

Date

SEP 21 1938

19

H. D. Hatfield Scout

Butler **KANSAS**Map No. 10 Sec. 14 Twp. 28 R. 7EWell No. 1 RampAdair & Morton

Company

Contractor

COMPLETED

SW NW SW

990 Ft. from N. Line Ft. from S. Line Ft. from E. Line330 Ft. from W. Line**SECTION PLAT**

0			

Location Rig up

Drilling and Remarks:

4000 acid
80 oil
S.W.

RECORDCased 7 in., 2670 ft.Sand Miss 2660Gas Oil Total Depth 2691**PRODUCTION**1st 24 hrs. Nat. 1st 24 hrs. after shot Gas Cu. Ft.Dry Hole Abandoned

Date

NOV 9 - 1938 19

H. D. Hatfield Scout