KANSAS

Form 51—5M—7-39—Palace

Butler

Section 15 Township 28 Range 7-E

Well No. #8 Brandt

Company Adair & Morton

NORTH Brandt Pool

WEST

EAST

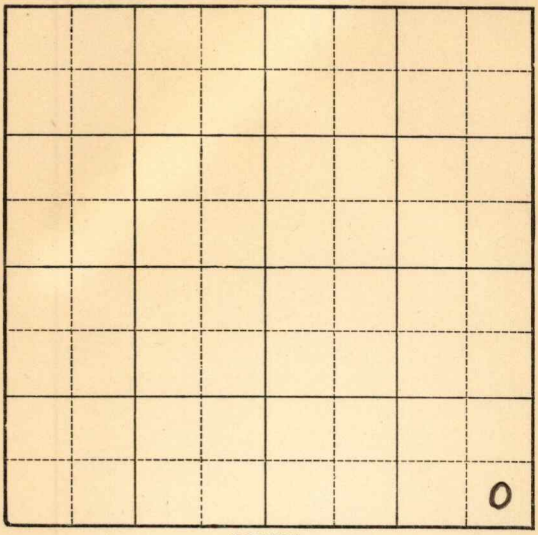

SOUTH

FORM 252-A 5M 4-39 KANSAS Butler

Sec. 15 Twp. 28 R. 7-E

Well No. #8 Brandt Farm

Adair & Morton Company

(Brandt)

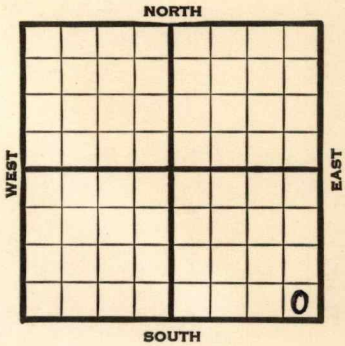

_____ Ft. from N. Line

330 Ft. from S. Line

330 Ft. from E. Line

_____ Ft. from W. Line

Elev. 1415

1939	REPORT
8/30	15" - 25'
	Drlg. 100'
9/7	12" - 686' Drlg. 775'
9/14	10" - 1415' Drlg. 1425'
9/21	8" - 2120' Drlg. 2230'
9/28	Miss. 2672' T.D. 2692' Run 6".
10/4	Miss. 2672'
	6" - 2672'
	T.D. 2701'
	P. B. to 2695'
	2000 acid.
	Pump 35 bbls.
	COMPLETED

Form 26—1M Bks.—2-29 KANSAS Butler

Map No. 10 Sec. 15 Twp. 28 R. 7E

Well No. E Brandt

Adair & Morton Company

Contractor

SE/c

FIRST REPORT

Ft. from N. Line

330 Ft. from S. Line

330 Ft. from E. Line

Ft. from W. Line

SECTION PLAT

			o

Brandt Pool

Location

Rig up

Drilling and Remarks:

15" @ 25'

Dr lg 100'

RECORD

Cased in., ft.

Sand

Gas

Oil

Total Depth

PRODUCTION

1st 24 hrs. Nat.

1st 24 hrs. after shot

Gas Cu. Ft.

Dry Hole

Abandoned

Date

AUG 30 1939 19

S. J. LEWIS Scout

Form 26—1M Bks.—2-29

Butler KANSAS

Map No. 10 Sec. 15 Twp. 28 R. 7E

Well No. 8 Brandt

Adair & Morton Company

Contractor

COMPLETED

SE /C

SECTION PLAT

			o

_____ Ft. from N. Line

330 Ft. from S. Line

330 Ft. from E. Line

_____ Ft. from W. Line

BRANDT POOL

Location _____

Rig up _____

Drilling and Remarks:

Miss 2672
6" C 2672
P.B 2695
2000 acid
Pump 35 B/h

RECORD

Cased _____ in., _____ ft.

Sand _____

Gas _____

Oil _____

Total Depth 2701

PRODUCTION

1st 24 hrs. Nat. _____

1st 24 hrs. after shot _____

Gas _____ Cu. Ft.

Dry Hole _____

Abandoned _____

Date

OCT 4 1939 19

S. J. LEWIS Scout