


Butler

Section 15 Township 28 Range 7-E

Well No. #10 Brandt

Company Adair & Morton

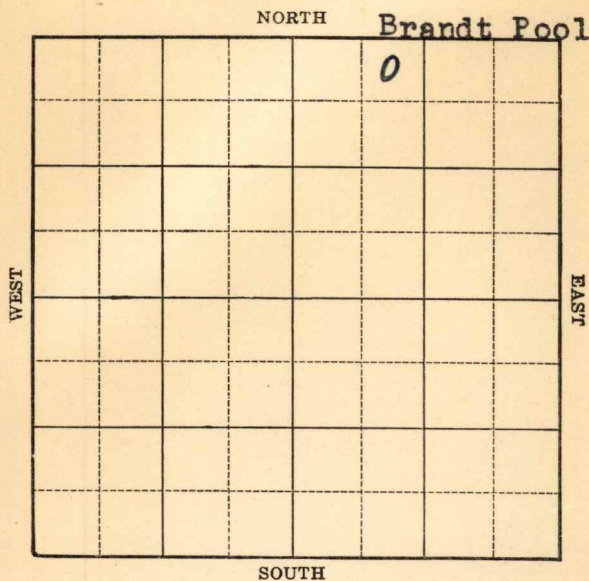

KANSAS

Butler

FORM 252-A 5M 2-40

Sec. 15 Twp. 28 R. 7-EWell No. #10 Brandt FarmAdair & Morton

Company

(Brandt)

330

Ft. from N. Line


Ft. from S. Line

Ft. from E. Line

990

Ft. from W. Line

Elev. 1463

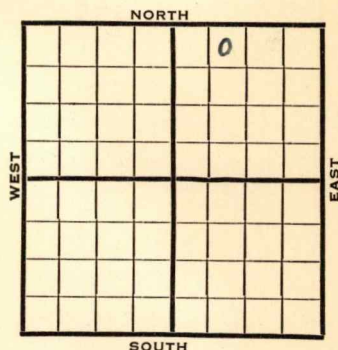

1940

REPORT

4/17

Machine.

4/26

Spud.

5/2

Drlg. 770'

5/9

12" - 890' 10" - 1492'

Drlg. 1625'

5/16

K.C. 2005' 8" - 2030'

Drlg. 2250'

5/23

Miss. 2721-63' TD. 5" - 2738'

Pay 2740-55' Testing.

5/29

Miss. 2721'

5" - 2738'

T.D. 2755'

2000 acid.

35 bbls.

COMPLETED

Map No. 10 Sec. 15 Twp. 28 R. 7EWell No. 10 BrandtAdair & Morton

Company

FIRST REPORT

Contractor

SECTION PLAT**NE NW NE**330 Ft. from N. Line

Ft. from S. Line

Ft. from E. Line

990 Ft. from W. Line**BRANDT POOL**

		0	

Location _____

Rig up _____

Drilling and Remarks:

Machine**RECORD**

Cased _____ in., _____ ft.

Sand _____

Gas _____

Oil _____

Total Depth _____

PRODUCTION

1st 24 hrs. Nat. _____

1st 24 hrs. after shot _____

Gas _____ Cu. Ft.

Dry Hole _____

Abandoned _____

Date

APR 17 1940₁₉S. J. LEWIS Scout

Map No. 10 Sec. 15 Twp. 28 R. 7EWell No. 10 BrandtAdair & Morton Company

Contractor

COMPLETED
NE NW NE330 Ft. from N. Line Ft. from S. Line Ft. from E. Line990 Ft. from W. Line

BRANDT POOL

SECTION PLAT

		0	

Location Rig up

Drilling and Remarks:

Miss 2721
5" @ 2738
2000 acid
35 1/2 ft

RECORDCased in., ft.Sand Gas Oil Total Depth 2755**PRODUCTION**1st 24 hrs. Nat. 1st 24 hrs. after shot Gas Cu. Ft.Dry Hole Abandoned

Date

MAY 29 1940 19S. J. LEWIS Scout