

Sec. 15 Twp. 28 R. 7-E

Well No. #11 Brandt Farm

Adair & Morton Company


(Brandt)

330 Ft. from N. Line

_____ Ft. from S. Line

990 Ft. from E. Line

_____ Ft. from W. Line

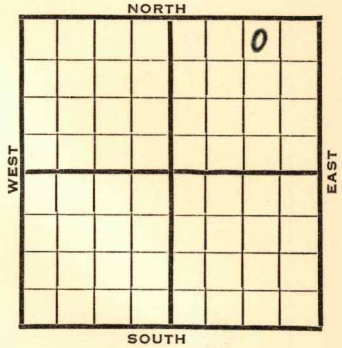

Elev. 1464

1940	REPORT
5/22	Cellar.
5/29	"
6/6	Drlg. 670'
6/13	12" - 865' Drlg. 1305'
6/20	10" - 1516' Drlg. 1915'
6/27	K. C. 1999' S.O. 2120-25'
	8" - 2180' Miss. 2724-34' T.D.
	Run 5".
7/3	5" - 2734' T.D. 2763'
	3000 acid.
7/10	Miss. 2724'
	5" - 2734'
	T.D. 2763'
	3000 acid.
	Pump 35 bbls.

COMPLETED

Map No. 10 Sec. 15 Twp. 28 R. 7E

Well No. 11 Brandt

Adair & Morton Company

Contractor

COMPLETED

SECTION PLAT

NW NE NE

			0

330 Ft. from N. Line

 Ft. from S. Line

990 Ft. from E. Line

 Ft. from W. Line

BRANDT POOL

Location

Rig up

Drilling and Remarks:

Miss 2724
5" @ 2734
3000 acid
Pump 35 H/L

RECORD

Cased in., ft.

Sand

Gas

Oil

Total Depth 2762

PRODUCTION

1st 24 hrs. Nat.

1st 24 hrs. after shot

Gas Cu. Ft.

Dry Hole

Abandoned

Date

JUL 10 1940 19

S. J. LEWIS Scout