


Section 15 Township 28 Range 7-E

Well No. #12 Brandt

Company Adair & Morton

NORTH Brandt Pool

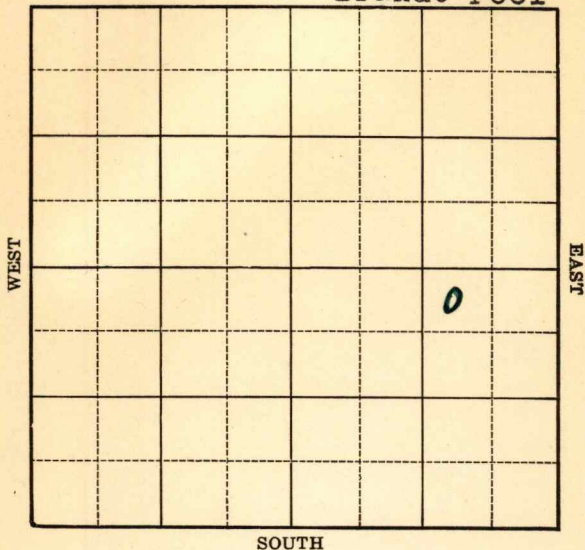

Sec. 15 Twp. 28 R. 7-E

Well No. #12 Brandt Farm

Adair & Morton Company

(Brandt)


330 Ft. from N. Line

_____ Ft. from S. Line

990 Ft. from E. Line

Ft. from W. Line

Elev. 1416

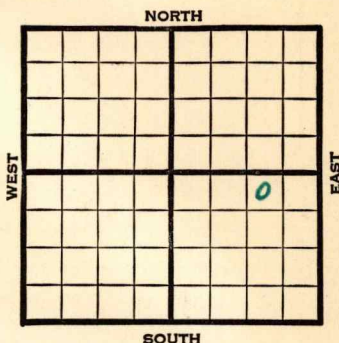[illegible]

Map No. 10 Sec. 15 Twp. 28 R. 7EWell No. 12 BrandtAdair & Morton

Company

FIRST REPORT

Contractor

FIRST REPORT**SECTION PLAT**

NW NE SE

			o

330 Ft. from N. Line Ft. from S. Line990 Ft. from E. Line Ft. from W. Line**BRANDT POOL**Location Rig up

Drilling and Remarks:

15" - 15'12" - 65010" - 1450Drlg. 1460**RECORD**Cased in., ft.Sand Gas Oil Total Depth **PRODUCTION**1st 24 hrs. Nat. 1st 24 hrs. after shot Gas Cu. Ft.Dry Hole Abandoned

Date

AUG 17 1940₁₉S. J. LEWIS Scout

Map No. 10 Sec. 15 Twp. 28 R. 7EWell No. 12 BrandtAdair & Morton

Company

Contractor

COMPLETED

NW NE SE

330 Ft. from N. Line Ft. from S. Line990 Ft. from E. Line Ft. from W. Line

BRANDT POOL

SECTION PLAT

			o

Location Rig up

Drilling and Remarks:

*Miss 2676**5" @ 2676**3000 acid**Pump 343 Rx.*

RECORD

Cased in., ft.Sand Gas Oil Total Depth 2710

PRODUCTION

1st 24 hrs. Nat. 1st 24 hrs. after shot Gas Cu. Ft.Dry Hole Abandoned

Date

SEP 4 1940

19

S. J. LEWIS Scout