

KANSAS


Butler

Form 51-5M-7-40-Palace

Section 15 Township 28 Range 7-E

Well No. #15 Brandt

Company Adair & Morton

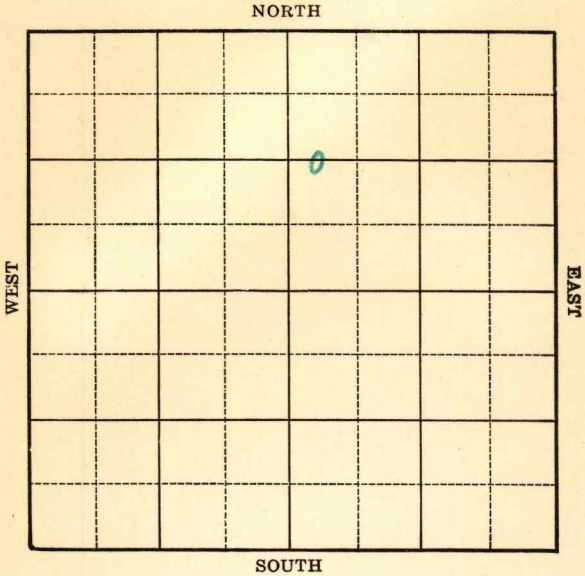

Sec. 15 Twp. 28 R. 7-E

Well No. #15 Brandt Farm

Adair & Morton Company

(Brandt)


1320 Ft. from N. Line

\_\_\_\_\_ Ft. from S. Line

\_\_\_\_\_ Ft. from E. Line

330 Ft. from W. Line

**Elev. 1439**

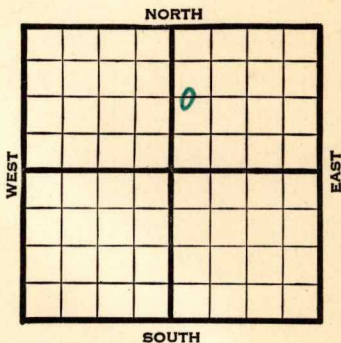

1941	REPORT
2/5	Machine.
2/13	Drlg. 640'
2/20	12" - 800' Drlg. 1450'
2/27	10" - 1490'
	Drlg. 2050'
3/6	8" - 2165' Miss. 2710-12' T.D.
	Run 7".
3/12	Miss. 2710'
	7" - 2707'
	T.D. 2738'
	3000 acid.
	Potential 336 bbls., pump.
	38. Gravity
	<b>COMPLETED</b>

Map No. 10 Sec. 15 Twp. 28 R. 7E

Well No. 15 Brandt

Adair & Morton Company

FIRST REPORT Contractor

C W L N E

1320 Ft. from N. Line

\_\_\_\_\_ Ft. from S. Line

\_\_\_\_\_ Ft. from E. Line

330 Ft. from W. Line

SECTION PLAT

		0	

BRANDT POOL

Location \_\_\_\_\_

Rig up \_\_\_\_\_

Drilling and Remarks:

Machine

RECORD

Cased \_\_\_\_\_ in., \_\_\_\_\_ ft.

Sand \_\_\_\_\_

Gas \_\_\_\_\_

Oil \_\_\_\_\_

Total Depth \_\_\_\_\_

PRODUCTION

1st 24 hrs. Nat. \_\_\_\_\_

1st 24 hrs. after shot \_\_\_\_\_

Gas \_\_\_\_\_ Cu. Ft.

Dry Hole \_\_\_\_\_

Abandoned \_\_\_\_\_

Date

FEB 5 1941 19

S. J. LEWIS Scout

Map No. 10 Sec. 15 Twp. 28 R. 7E

Well No. 15 Brandt

Adair & Morton Company

Contractor

COMPLETED

SECTION PLAT

C W L N E

1320 Ft. from N. Line

\_\_\_\_\_ Ft. from S. Line

\_\_\_\_\_ Ft. from E. Line

330 Ft. from W. Line

		o	

BRANDT POOL

Location \_\_\_\_\_

Rig up \_\_\_\_\_

Drilling and Remarks:

*Miss 2710*  
*7" @ 2707*  
*3000 acid*  
*Pump 836 P & S*  
*35° Gr*

RECORD

Cased \_\_\_\_\_ in., \_\_\_\_\_ ft.

Sand \_\_\_\_\_

Gas \_\_\_\_\_

Oil \_\_\_\_\_

Total Depth 2785

PRODUCTION

1st 24 hrs. Nat. \_\_\_\_\_

1st 24 hrs. after shot \_\_\_\_\_

Gas \_\_\_\_\_ Cu. Ft.

Dry Hole \_\_\_\_\_

Abandoned \_\_\_\_\_

Date

MAR 12 1941 19

S. J. LEWIS Scout