KANSAS


FORM 51 5M 1-42 PETROL

Bulter

Section 15 Township 28 Range 7-E

Well No. #6 Cannon

Company Adair & Morton

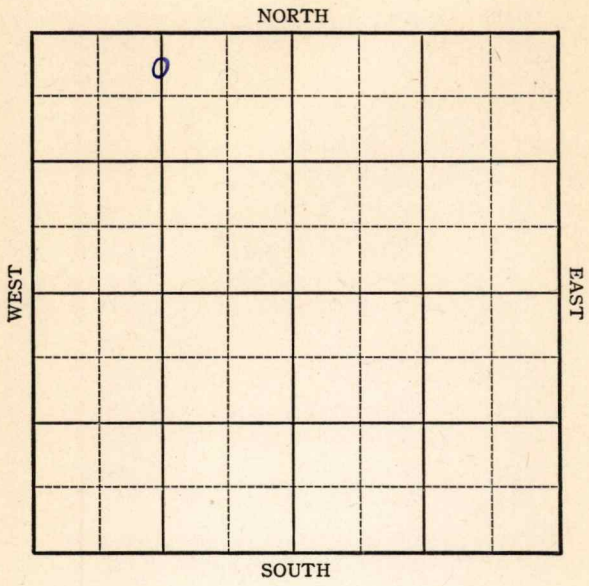

FORM 252-A
5M 9-43 GASS

KANSAS Butler

Sec. 15 Twp. 28 R. 7-E

Well No. #6 Cannon Farm

Adair & Morton Company


330 Ft. from N. Line

Ft. from S. Line

1320 Ft. from E. Line

Ft. from W. Line

Elev. 1455

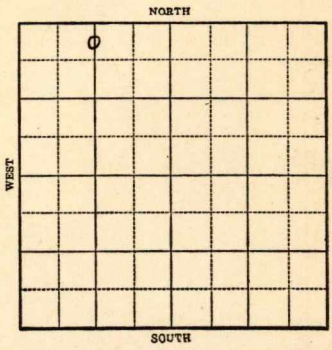

1943	REPORT
9/22	Location
9/29	Machine
10/6	Spud
10/13	Drlg. 700'
10/20	12" @ 835 15" @ 1525 Lans 1685 Drlg. 1826
10/27	KC 2005 8" @ 1873 Drlg. 2720'
11/3	Miss 2726 7" @ 2726 3000 acid Pump 200 Pot. T.D. 2746' Gravity 36

COMPLETED

Form 26 200 Bks 5-42 Petrol Butler

KANSAS

Map No. 78 Sec. 15 Twp. 28 R. 7E

Well No. 6 Cannon

Adair & Morton Company

FIRST REPORT Contractor

C N L NW


330 Ft. from N. Line

Ft. from S. Line

1320 Ft. from E. Line

Ft. from W. Line

SECTION PLAT

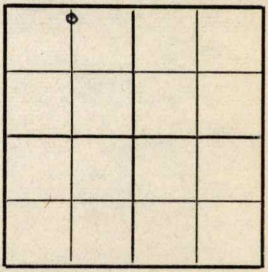

Miscellaneous

Location X

Rig up

Drilling and Remarks:

RECORD

Cased in., ft.

Sand

Gas

Oil

Total Depth

PRODUCTION

1st 24 hrs. Nat.

1st 24 hrs. after shot

Gas Cu. Ft.

Dry Hole

Abandoned

Date

SEP 2 2 1943 19 S. J. LEWIS Scout

Form 26 200 Bks 5-42 Petrol Butler

KANSAS

Map No. 10 Sec. 15 Twp. 28 R. 7E

Well No. 6 Cannon

Adair & Morton Company

COMPLETED Contractor

C N L NW


330 Ft. from N. Line

Ft. from S. Line

1320 Ft. from E. Line

Ft. from W. Line

SECTION PLAT

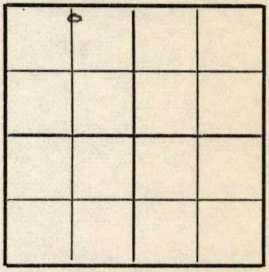

Miscellaneous

Location

Rig up

Drilling and Remarks:

Miss 2726
7" @ 2724
3000 acid
Pump 200 Bbl
86° Gr

RECORD

Cased in., ft.

Sand

Gas

Oil

Total Depth 2746

PRODUCTION

1st 24 hrs. Nat.

1st 24 hrs. after shot

Gas Cu. Ft.

Dry Hole

Abandoned

Date

NOV 3 1943

19 S. J. LEWIS Scout