

Butler

KANSAS

Section 12 Township 29 Range 5E

Well No. 2 Price

Company Morrison Producing

NORTH

12

WEST

	0						

EAST

SOUTH

Butler

KANSAS

12

29

5E

Sec. _____ Twp. _____ R. _____

#2 Price

Well No. _____ Farm _____

Morrison Prod.

Company _____

Morrison

Contractor _____

848

Ft. from N. Line


Ft. from S. Line

Ft. from E. Line

724

Ft. from W. Line

SE NW SW

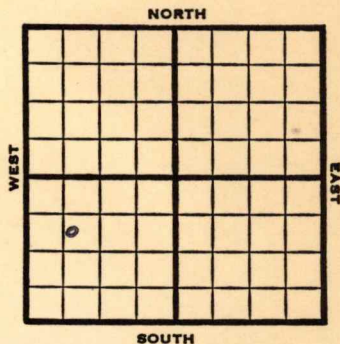

1953 Elev. -

REPORT

1/28

Spud 12-11-52

Oil Well

TD 2829

8" @ 99

Bart 2799

TD 2799

5" @ 2799

DD 2829

26 qt.

Comp. 2 bopd

FIRST REPORT

+

COMPLETED

Butler

KANSAS ✓

Sec. 12 Twp. 29 R. 5EWell No. #2 Price FarmMorrison Prod. Company

Contractor


848 Ft. from N. Line

Ft. from S. Line

Ft. from E. Line

724 Ft. from W. Line

SE NW SW

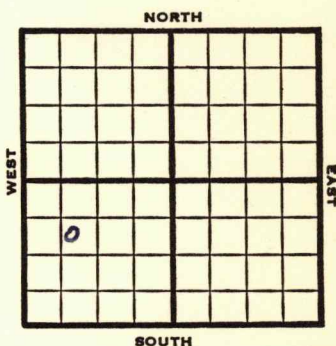1952 **Elev. 1374'** REPORT

12/17 Drlg. 800'

1953

1/23

Spud 12-11-52 Oil well T^u 2834'
 8" @ 99 **Bart. 2798'** TD 2799
 5" @ 2799 DD 2834' 25 qt/
 Comp. 10 BOPD 20 BW

COMPLETED

DD 2834 25 qt/ Comp. 10 bopd 20 bw

J. G. McGEHEE

County **Butler** State **Kansas**
 Sec. **12** (Blk.) **29** (Sur.) **5E** Map No.
 Operator **Morrison Prod.**
 Well No. **2** Farm **Price**
 Elev. Location **SE NW SW**

FIRST REPORT

COMPLETE

848 Ft. From **N** Line **SW**
724 Ft. From **W** Line **Quarter**
 1st. Report **JAN 28 1953**
 Completion **JAN 28 1953**
 Remarks
Morrison - Contr.
 Spudding Date **12-11-52**

Drlg. Data **Oil well TD 2829**
8" @ 99 Bart. 2799 TD 2799
5" @ 2799 DD 2829 26 qt/
Comp. 2 bopd

J. G. McGEHEE

County Butler State Kansas

Sec. 12 (Blk. Twp.) 29 (Sur. Rge.) 5E Map No.

Operator Morrison Prod.

Well No.	2	Farm	Price
----------	---	------	-------

Elev.	Location	SE	NW	SW

848 Ft. From N Line SW

724 Ft. From W Line Quarter

1st. Report DEC 17 1952

Completion

Remarks

Spudding Date _____

Drlg. Data

drlg. 800

J. G. McGEHEE