






Map No. K11 Sec. 12 Twp. 29 R. 5

Well No. 4 Price Farm \_\_\_\_\_  
Derby Oil Company. \_\_\_\_\_

NORTH

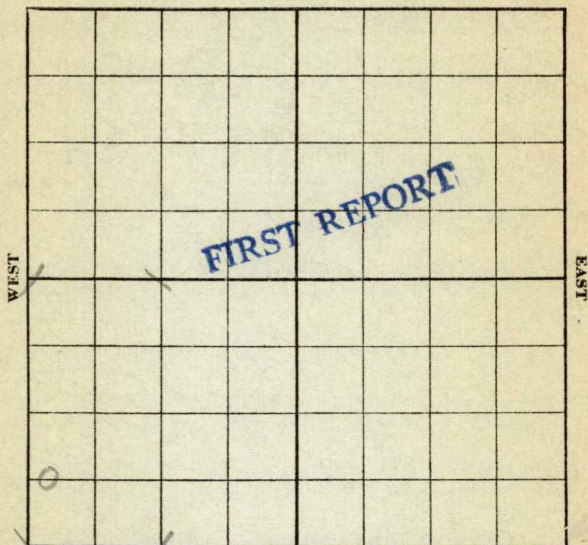

660 S

SOUTH

200 W

Location \_\_\_\_\_

Rig up  \_\_\_\_\_

Drilling and Remarks:

RECORD

Cased \_\_\_\_\_ in., \_\_\_\_\_ ft.

Sand \_\_\_\_\_

Gas \_\_\_\_\_

Oil \_\_\_\_\_

Total Depth \_\_\_\_\_

PRODUCTION

1st 24 hrs. Nat. \_\_\_\_\_

1st 24 hrs. after shot \_\_\_\_\_

Gas \_\_\_\_\_ Cu. Ft.

Dry Hole \_\_\_\_\_

Abandoned \_\_\_\_\_

Date

8/4 1920

Pyle

Scout.

Map No. K 11 Sec. 12 Twp. 29 R. 5  
 Well No. 4 Price  
The Derby Oil Company  
 Contractor

SECTION PLAT

----- Ft. from N. Line  
660 Ft. from S. Line  
 ----- Ft. from E. Line  
200 Ft. from W. Line


COMPLETED

Location -----  
 Rig up -----  
 Drilling and Remarks:

RECORD

Cased ----- in., ----- ft.  
 Sand 2788 - 2810  
 Gas -----  
 Oil -----  
 Total Depth -----

PRODUCTION

1st 24 hrs. Nat. 75 bbls  
 1st 24 hrs. after shot -----  
 Gas ----- Cu. Ft.  
 Dry Hole -----  
 Abandoned -----

Date

10/21 1920

Pyle

Scout