



Map No. 21 Sec. 12 Twp. 29 R. 5

Well No. 3 Price Farm \_\_\_\_\_  
Grace Oil Company \_\_\_\_\_


only oil

\_\_\_\_\_ Ft. from N. Line

660 Ft. from S. Line

\_\_\_\_\_ Ft. from E. Line

1120 Ft. from W. Line

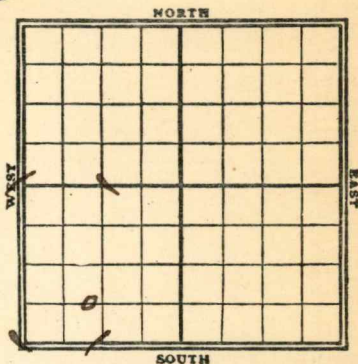

1920

REPORT

FIRST REPORT

<u>7/11</u>	<u>Rig</u>	
<u>24</u>	<u>Dry @ 300'</u>	
<u>8/14</u>	<u>Dry @ 1800.</u>	
<u>8/10</u>	<u>Dry @ 1815'</u>	
<u>8/29</u>	<u>Dry @ 2260'</u>	
<u>9/10</u>	<u>2766 - 2826</u>	<u>80 gal</u>

Map No. K11 Sec. 12 Twp. 29 R. 5

Well No. 3 Price  
Grace Oil Company

Contractor \_\_\_\_\_

SECTION PLAT

\_\_\_\_\_ Ft. from N. Line

660 Ft. from S. Line

\_\_\_\_\_ Ft. from E. Line

1120 Ft. from W. Line

**FIRST REPORT**


Location \_\_\_\_\_

Rig up  \_\_\_\_\_

Drilling and Remarks:

RECORD

Cased \_\_\_\_\_ in., \_\_\_\_\_ ft.

Sand \_\_\_\_\_

Gas \_\_\_\_\_

Oil \_\_\_\_\_

Total Depth \_\_\_\_\_

PRODUCTION

1st 24 hrs. Nat. \_\_\_\_\_

1st 24 hrs. after shot \_\_\_\_\_

Gas \_\_\_\_\_ Cu. Ft.

Dry Hole \_\_\_\_\_

Abandoned \_\_\_\_\_

Date

7/11 1920

**Pyle** Scout

Map No. H11 Sec. 12 Twp. 29 R. 5

Well No. 3 Price  

Contractor

SECTION PLAT

----- Ft. from N. Line  
660 Ft. from S. Line  
 ----- Ft. from E. Line  
1120 Ft. from W. Line

COMPLETED


Location -----

Rig up -----

Drilling and Remarks:

RECORD

Cased ----- in., ----- ft.

Sand 2766-2826

Gas -----

Oil -----

Total Depth -----

PRODUCTION

1st 24 hrs. Nat. 80 bbls

1st 24 hrs. after shot -----

Gas ----- Cu. Ft.

Dry Hole -----

Abandoned -----

Date

9/16 19120

Pyle

Scout