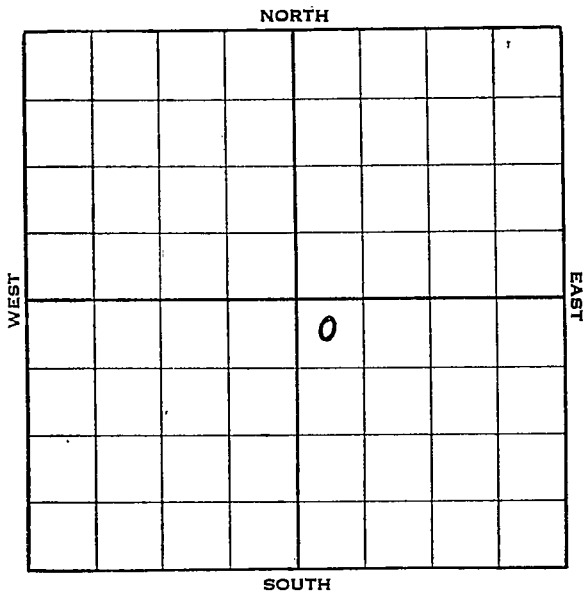


KANSAS

Woodson

FORM 51 5M 2-38 TPCO.

Section 35 Township 25 Range 14-EWell No. 1 EllisCompany Joe Nathan et al

Map No. 17 Sec. 35 Twp. 25 R. 14EWell No. 1 EllisJoe Nathan et al

Company

Contractor

FIRST REPORT

NW SE

330 Ft. from N. Line Ft. from S. Line Ft. from E. Line330 Ft. from W. Line

SECTION PLAT

		D	

Location Rig up

Drilling and Remarks:

RU Mach.

RECORD

Cased in., ft.Sand Gas Oil Total Depth

PRODUCTION

1st 24 hrs. Nat. 1st 24 hrs. after shot Gas Cu. Ft.Dry Hole Abandoned

Date

JUL 20 1938 19 H. D. Hatfield Scout

Woodson KANSAS

Map No. 17 Sec. 35 Twp. 25 R. 14EWell No. 1 EllisJoe Nathan etal Company

Contractor

ABANDONED
NW SE330 Ft. from N. Line Ft. from S. Line Ft. from E. Line330 Ft. from W. Line

SECTION PLAT

		0	

Location Rig up

Drilling and Remarks:

HFW

DFA

RECORD

Cased 6 in., 1461 ft.Sand MISS 1521Gas Oil Total Depth 1611

PRODUCTION

1st 24 hrs. Nat. 1st 24 hrs. after shot Gas Cu. Ft.Dry Hole Abandoned

Date

SEP 14 1938 19 H. D. Hatfield Scout