

KANSAS

Form 51—5M—7-39—Palace

Barton

Section 34 Township 16 Range 11-W

Well No. #1 Kroutwurst

Company Sinclair Prairie

NORTH

Prusa Pool

WEST

EAST

0							

SOUTH

KANSAS

Barton

Sec. 34 Twp. 16 R. 11-W

Well No. #1 Kroutwurst Farm

Sinclair-Prairie Company


(Brusa)

_____ Ft. from N. Line

330 Ft. from S. Line

Ft. from E. Line

330 Ft. from W. Line

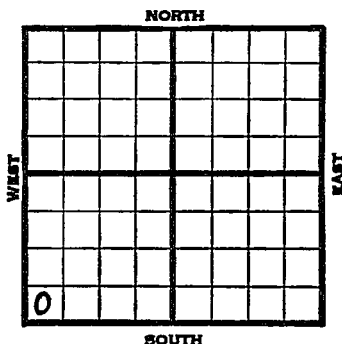

Feb. 1916

[illegible]

Barton

KANSAS

Map No. 55 Sec. 34 Twp. 16 R. 11WWell No. 1 KroutwurstSinclair Prairie

Company

Contractor

FIRST PEPPI
SW/C

SECTION PLAT

 Ft. from N. Line330 Ft. from S. Line Ft. from E. Line330 Ft. from W. Line

PRUSA POOL

Location Rig up

Drilling and Remarks:

12" - 100Drlg. 765

RECORD

Cased in., ft.Sand Gas Oil Total Depth

PRODUCTION

1st 24 hrs. Nat. 1st 24 hrs. after shot Gas Cu. Ft.Dry Hole Abandoned

Date

 19S. J. LEWISScout

Barton KANSAS

Map No. 55 Sec. 34 Twp. 16 R. 11WWell No. 1 KroutwurstSinclair Prairie

Company

Contractor

ABANDONED

SW/C

 Ft. from N. Line330 Ft. from S. Line Ft. from E. Line330 Ft. from W. Line

PRUSA POOL

SECTION PLAT

Location Rig up

Drilling and Remarks:

*Re work to 3411**Basal Sand 3440**Noshow*

RECORD

Cased in., ft.Sand Gas Oil Total Depth 3445

PRODUCTION

1st 24 hrs. Nat. 1st 24 hrs. after shot Gas Cu. Ft.Dry Hole Abandoned

Date

JAN 10 1940 19

S. J. LEWIS

Scout