


Section 35 Township 16 Range 11W


Well No. 1 Burmeister

Company Trans-Era

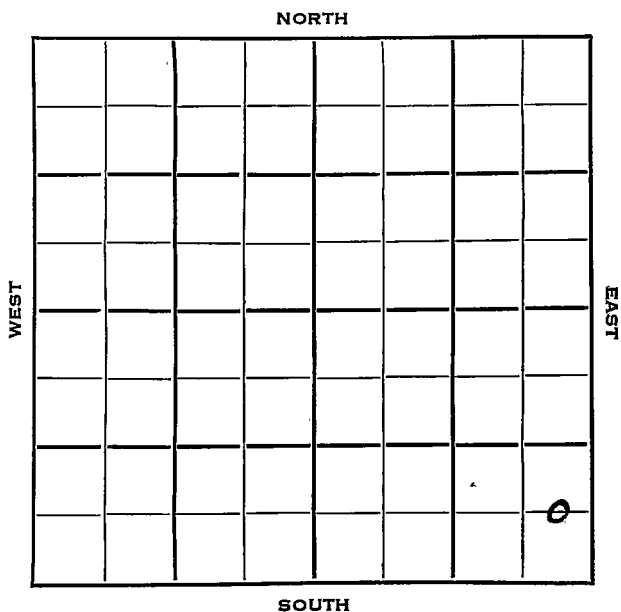

Barton **KANSAS** ✓Sec. 35 Twp. 16 R. 11WWell No. #1 Burmeister FarmTrans-Era CompanyTrans-Era Contractor Ft. from N. Line660 Ft. from S. Line330 Ft. from E. Line Ft. from W. Line

C E L S E S E

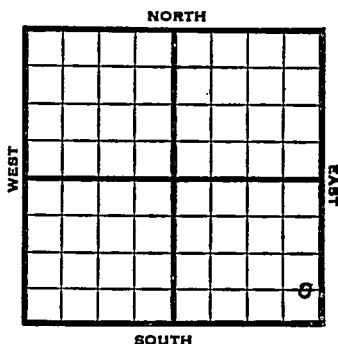


1952 Elev. '1934' REPORT

11/26 Spud 11-19-52
 8" @ 250
 Drlg. 2745'

12/3 Spud 11-19-52
 D&A
 TD 3422
 8" @ 250
 Heeb 2980, Br. lime 3080',
 Lans 3100
 DST 3273-83, opn 1 hr., rec.
 10' mud 0#
 Cong. 3378', Arb. 3403
 TD 3422
 D&A

ABANDONED

County Barton State Kansas
 Sec. 35 (Blk. 16) (Sur. 11W) Map No. 11W
 Operator Trans-Era
 Well No. 1 Farm Burmeister
 Elev. CE L SE SE Location

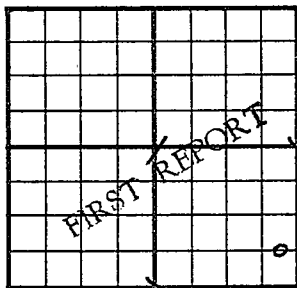

660 Ft. From S Line SE

330 Ft. From E Line Quarter

1st. Report NOV 26 1952

Completion

Remarks


Trans-Era - Contr.

Spudding Date 11-19-52

Drlg. Data

8" @ 250 drlg. 2745

J. G. McGEHEE

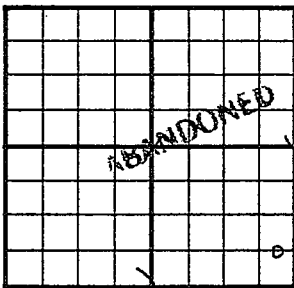County Barton State KansasSec. 35 (Blk. 16 (Sur. 11W Map No.)
(Twp.) (Rge.)Operator Trans-EraWell No. 1 Farm BurmeisterElev. 1934 Location C E L S E S E

660 Ft. From S Line SE

330 Ft. From E Line Quarter

1st. Report

Completion DEC 3 1952

Remarks

Trans-Era - Contr.Spudding Date 11-19-52Drlg. Data D & A TD 34228" @ 250 Heeb. 2980 Br. lime 3080Lans. 3100 DST 3273-83 open 1 hr.Rec. 10' mud 0# Cong. 3378Arb. 3403 TD 3422D & A

J. G. McGEHEE