

KANSAS

Barton

Section 35 Township 16 Range 11WWell No. #1 EhlerCompany Eldorado Ref. Etal.

Bloomer

NORTH

WEST

o							

EAST

SOUTH

KANSAS

Barton

Sec. 35 Twp. 16 R. 11-W

Well No. #1 Ehler Farm

Eldorado Ref. et al Company

Bloomer Pool


990' Ft. from N. Line

Ft. from S. Line

Ft. from E. Line

330' Ft. from W. Line

SW NW NW

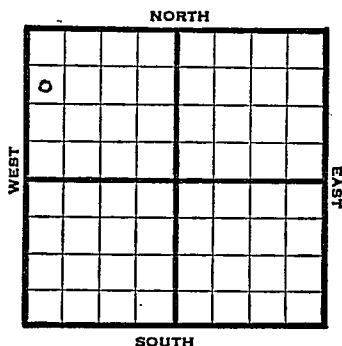

1947

Elev. 1939' REPORT

12/10

Loc.

12/17

"

12/30

8" @ 360'
Drlg. 3073'

3404
1939
1465

1948

1/7

Arbuckle 3404-12' TD
5" @ 3406'
RUST

1/14

"

1/21

Arb. 3404'
5" @ 3406'
TD 3424'
Abd.

ABANDONED

Map No. _____ Sec. 35 Twp. 16 R. 11W

Well No. 1 Ehler

Eldorado Ref. etal. Company

FIRST REPORT Contractor

SW NW NW


SECTION PLAT

990 Ft. from N. Line

_____ Ft. from S. Line

_____ Ft. from E. Line

330 Ft. from W. Line

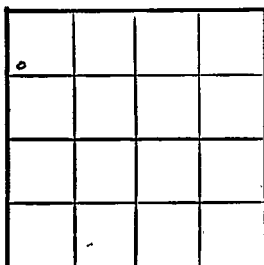

Barton County

Location X

Rig up _____

Drilling and Remarks:

RECORD

Cased _____ in., _____ ft.

Sand _____

Gas _____

Oil _____

Total Depth _____

PRODUCTION

1st 24 hrs. Nat. _____

1st 24 hrs. after shot _____

Gas _____ Cu. Ft.

Dry Hole _____

Abandoned _____

Date

DEC 10 1947

19

S. J. LEWIS

Scout

Map No. 55 Sec. 35 Twp. 16 R. 11W

Well No. 1 Ehler

Eldorado Ref. etal. Company

ABANDONED

Contractor

SWNW NW


E 11/1987
SECTION PLAT

990 Ft. from N. Line

_____ Ft. from S. Line

_____ Ft. from E. Line

330 Ft. from W. Line

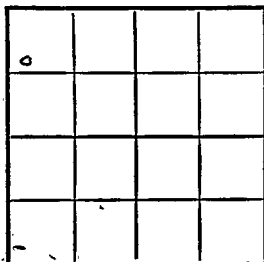

Barton County

RECORD

Location _____

Cased _____ in., _____ ft.

Rig up _____

Sand _____

Drilling and Remarks:

Gas _____

Oil _____

Total Depth 3424

Act 3404

5" 3406

PRODUCTION

1st 24 hrs. Nat. _____

1st 24 hrs. after shot _____

Gas _____ Cu. Ft.

Dry Hole _____

Abandoned _____

Date

JAN 21 1948 19

S. J. LEWIS Scout