

Section 35 Township 16 Range 11WWell No. ~~#1~~ #2 Ehler (B)Company Elreco

NORTH

WEST

EAST

SOUTH

Sec. 35 Twp. 16 R. 11W

Well No. #1
#2 Ehler (B) Farm

Elreco Company

Contractor

Semi Wildcat


330 Ft. from N. Line

Ft. from S. Line

330 Ft. from E. Line

Ft. from W. Line

NE NE NW

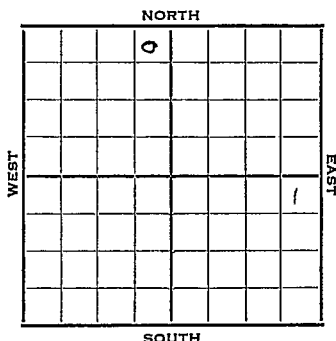

Derby-DHM Shell \$2500

1952 Elev. 1931' REPORT

6/18 RU
6/25 8" @ 305' Anhy 740'
Drlg. 1959'
7/2 Heeb. 2972 Tor 2992 Br Li 3073
Lans. KC 3088
DST 3300-3317 1/2 hr. 60' wtr & 15'
mcw 1000A Cong. 3370'
Arb. 3381 SO 5" @ 3382 TD 3385
7/9 CO 3385 DD 3387 SO 500 A
S/21 BO
7/17 S/33½ BOPH for 3 hrs.
7/23 NR
7/30 Spud 6-19-52
Oil well TD 3387' 8" @ 305'
Anhy 740' Heeb 2972' Tor. 2992'
Br. lime 3073' Lans. 3088'
DST 3300-3317 open ½ hr. rec 60' wtr.
15' MCW, 1000# Cong. 3370'
Arb. 3381' 5" @ 3382 TD 3385
CO to 3385 DD 3387 500 A
S/21 BO S/33½ BOPH
Comp. 357 BOPD

COMPLETED

County Barton State Kansas

Sec. 35 (Blk. Twp.) 16 (Sur. Rge.) 11W Map No.

Operator Elreco

Well No. 2 Farm Enter

Elev. Location NE NE NW

FIRST REPORT

See

330 Ft. From N Line NW

330 Ft. From E Line Quarter

Ist. Report JUN 1 8 1952

Completion

Remarks Derby-DHM Shell

collection \$ 2500.

Spudding Date

Drig. Data Semi Wildcat

RU

Barton Kansas

Map No. _____ Sec. 35 Twp. 16 R. 11W

Well No. 1 Ehler (B)

Elreco Company

CORRECTION Contractor

NE NE NW

SECTION PLAT

330 Ft. from N. Line

_____ Ft. from S. Line

330 Ft. from E. Line

_____ Ft. from W. Line

	<u>0</u>		

Location _____

Rig up _____

Drilling and Remarks:

Reported

2 Ehler

RECORD

Cased _____ in., _____ ft.

Sand _____

Gas _____

Oil _____

Total Depth _____

PRODUCTION

1st 24 hrs. Nat. _____

1st 24 hrs. after shot _____

Gas _____ Cu. Ft.


Dry Hole _____

Abandoned _____

Date

JUN 25 1952 19

J. G. MCGEHEE Scout

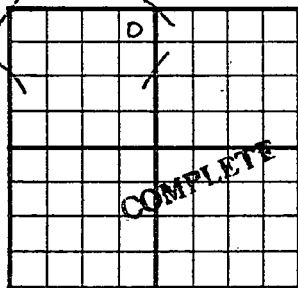County Barton State KansasSec. 35 (Blk.) 16 (Sur.) 11W Map No.Operator ElrecoWell No. 1 Farm Ehler "B"Elev. -1931 Location NE NE NW330 Ft. From N Line NW330 Ft. From E Line Quarter1st. ReportCompletion JUL 30 1952Remarks Semi WildcatSpudding Date 6-19-52Drlg. Data Oil well TD 33878" @ 305 Anhy 740 Heeb. 2972Tor. 2992 Br. lime 3073 Lans. 3088DST 3300-3317 open $\frac{1}{2}$ hr. Rec. 60' wtr15' mcw 1000 # Cong. 3370 Arb. 33815" @ 3382 TD 3385 CO to 3385 DD 3387500 A. S/ 21 bo S/ 33 $\frac{1}{2}$ bophComp. 357 bopdJ. G. McGEHEE