KANSAS


Barton

SECTION 35 TOWNSHIP 16 S RANGE 11 W

WELL NO. # 1 Holmolka

COMPANY Francis O & G & Kaiser

NORTH C S/2 NW NE

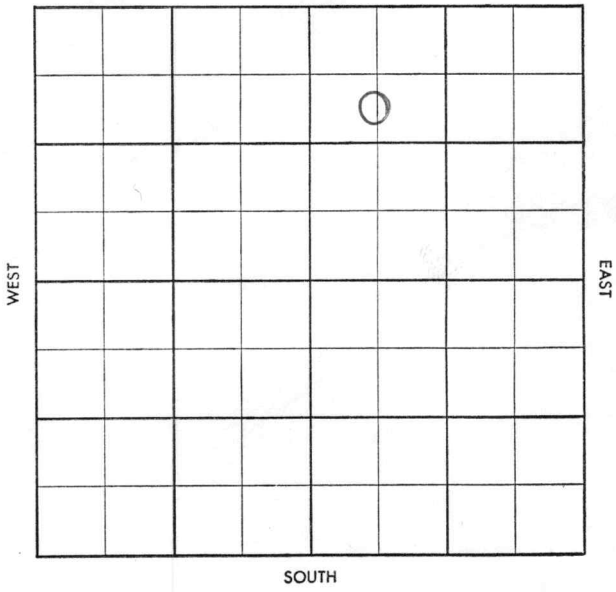

FORM 504-3 SUNRAY

No Kraft
X Kraft-Prusa

S-513-B

County Barton Elev.

Sec. 35 Twp. 16S Rge. 11W

Company Francis Oil & Gas (Tulsa) and Kaiser

Farm Name Holmolka No. 1

TOPS	DEPTH	LOG	DATUM
Anh.	785		
Tp.			
H.			
Tr.			
Dg.			
B. L.			
L.			
K.C.			
B.K.C.			
Ce.			
C.			
M.			
M.			
K.			
Mz.			
Mq.			
V.			
S.			
S.			
A.			
R.			
Pf.			
G.			
T.D.			

Loc. in Sec. c S/2 NW NE

Geol.

Contr. K. & E. Drlg, Tools Rig #2

Pool Kraft-Prusa

FIRST REPORT

SEP. [illegible]

Date Comm. Spud 9/7/58 Shell - (FO)

8" @ 355 w/185, Drlg 1900

Co. Lse. No. Sec. T. R.

Twp. X Pool Kraft-Prusa

Ce. X Facet. X

S-513-B

County Barton Elev. 1917 DF 1920 KB

Sec. 35 Twp. 16S Rge. 11W

Company Francis Oil & Gas (Tulsa) and Kaiser

Farm Name Holmolka No. 1

TOPS	DEPTH	LOG	DATUM
Anh.	785		
Tp. ~~Topeka~~	~~2426~~	2426	
~~Hb.~~ TP		2719	
~~Tr.~~ H		2970	
~~Dg.~~ TR		2988	
~~Br.~~ Dg		3000	
~~L.~~ BL		3072	
~~K.C.~~ LSG		3081	
B.K.C.			
Ce.			
C.			
M.			
M.			
K.			
Mz.			
Mq.			
V.			
S.			
S.			
A.		3381	
R.			
Pf.			
G.			
T.D.	3404	3403	

Loc. in Sec. c S/2 NW NE

Geol.

Contr. K. & E. Drlg. Tools Rig #2

Pool Kraft-Prusa

ABANDONED

SEP 17 '58

Date Comm. Spud 9/7/58 Shell - (FO)

8" @ 355 w/185, Drlg 1900 SEP 17 '58

D&A

Co. Lse. No. Sec. T. R.