

Butler


KANSAS

SECTION 1 TOWNSHIP 29 RANGE 5 E

WELL NO. #7-A Haggart

COMPANY Merriessn Production

NORTH

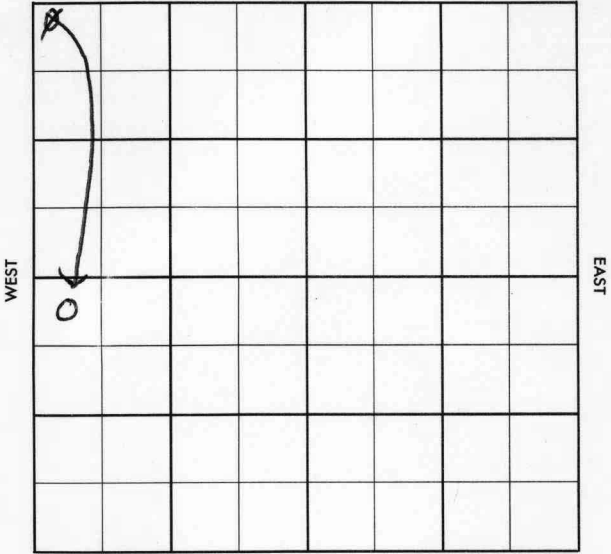

SOUTH

Butler

KANCA

SEC. 1	TWP. 29	R. 5E
-----------	------------	----------

WELL NO. #7-A Haggart FARM

COMPANY Morrison Production

CONTRACTOR Co. Tools


37 Fox-Bush
Ft. from N. Line

Ft. from S. Line

Ft. from E. Line

175 Ft. from W. Line

NW NW ~~NW~~
SW

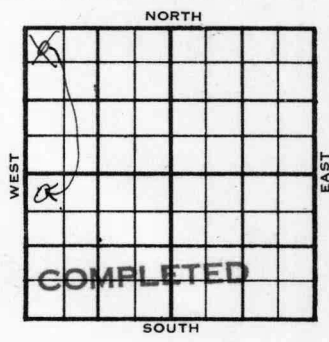

1956	ELEVATION	REPORT
------	-----------	--------

1-18	Location (Water input well)	
------	-----------------------------	--

County **Butler** Elev. _____
 Sec. **1** Twp. **29** Rge. **5E**
 Company **Morrison Production**
 Farm Name **Haggart** No. **7-A**

TOPS	DEPTH	LOG	DATUM	Loc. in Sec.
Anh.				NW NW NW
Tp.				37' NL
H.				175' WL
Tr.				
Dg.				
Bl.				
L.				Geol. _____
K.C.				Contr. _____
B.K.C.				
Ce.				Co. tools
C.				
M.				Pool
M.				Fox-Bush
K.				
Mz.				
Ma.				
V.				
S.				
S.				
A.				
R.				
Pe.				
G.				
T.D.				

JAN 18 '56
 FIRST REPORT

Date Comm. **Water input well**

Location

Co.
 Lse.
 No.
 Sec.
 T.
 R.

CORRECTION

FORM 513 REV. SUNRAY

County Butler Elev. 136'
 Sec. 1 Twp. 29 Rge. 5E
 Company Morrison Production
 Farm Name Haggart No. 7-A

TOPS	DEPTH	LOG	DATUM	Loc. in Sec.
Anh.				NW NW NWSW
Tr.				
Tr. <u>Bartl</u>	<u>2805</u>		<u>1444</u>	37' NL
Dg.				175' WL
Bl.				
L.				Geol.
N.C.				Contr.
B.K.C.				Co. tools
Ce.				Pool
C.				Fox-Bush
M.				
M.				
K.				
Mz.				
Ma.				
V.				
S.				<div style="border: 1px solid black; padding: 5px; display: inline-block;"> * COMPLETE </div>
S.				
A.				
R.				
Pe.				
G.				
SB	<u>2811</u>			MAR 7 1956

Date Comm. Water input well
 Location JAN 25 '56 8⁵/₈ 96/21
 FEB 1 '56 ✓ FEB 8 '56 ✓ FEB 15 '56 5¹/₂ 282
 FEB 22 '56 DD 2820 TD FU 70'
oil below 14 hrs P. 3 2818
 FEB 29 '56 ✓ MAR 7 '56 P. 7 Bopd no/wt

D.H.