


Section 21 Township 25 Range 15E

Well No. 11 Lauber

Company Schoonover & Young

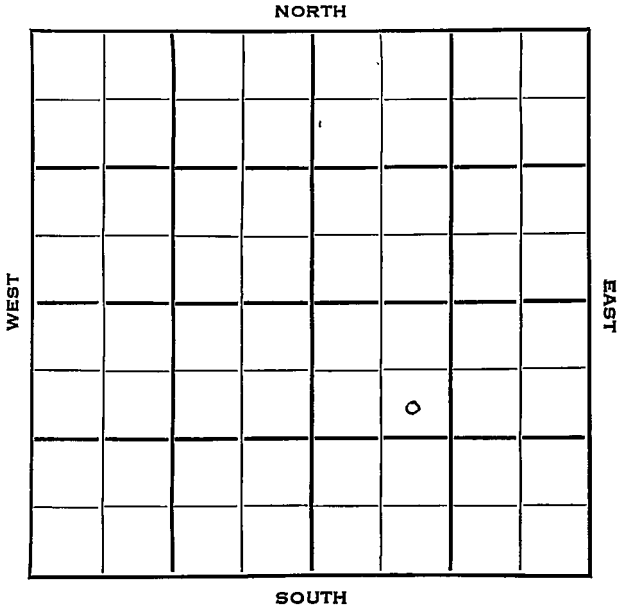

Sec. 21 Twp. 25 R. 15E

Well No. #11 Lauber Farm

Schoonover & Young Company

Contractor


990 Ft. from N. Line

Ft. from S. Line

Ft. from E. Line

990 Ft. from W. Line

SE NW SE

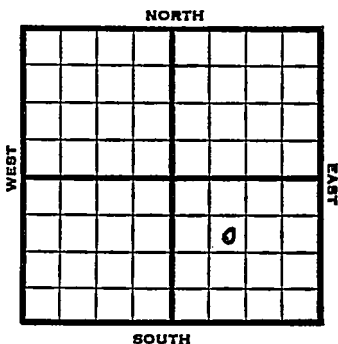

1953

Elev. -

REPORT

4/8

Spud 4-2-53  
8" @ 45  
Miss 1495  
TD 1496  
5" @ 1496'

4/15

Spud 4-2-53  
Oil Well  
TD 1508'  
8" @ 45  
Miss 1495,  
TD 1496  
5" @ 1496  
DD 1508  
1000 A  
Comp 8 bopd.

**COMPLETED**



