


Kansas

Map No. _____ Sec. 1 Twp. 29 R. 25

Well No. 8 Lentz Farm _____
Bradent & Gore Company _____

NORTH

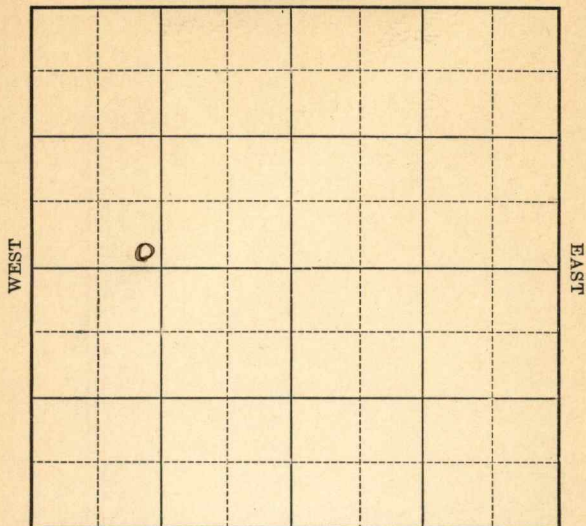

SOUTH

COMPLETED

Location _____

Rig Up _____

Drilling Remarks: _____

Drilling Remarks: _____

RECORD

Cased _____ in. _____ ft.

Sand _____

Gas _____

Oil _____

Total Depth _____

PRODUCTION

1st 24 hrs. Nat. _____

1st 24 hrs. after shot _____

Gas _____ cu. ft.

Dry Hole _____

Abandoned _____

Map No. *Kes 11* Sec *1* Twp. *29* R. *5*

Well No. *8 Lantz*
Braden & Gave Company

Contractor

FIRST REPORT

SECTION PLAT

----- Ft. from N. Line

200 Ft. from S. Line

----- Ft. from E. Line

1120 Ft. from W. Line

| | | | |
|--|--|--|--|
| | | | |
| | | | |
| | | | |
| | | | |
| | | | |

Location -----

Rig up -----

Drilling and Remarks:

Rigs

RECORD

Cased ----- in., ----- ft.

Sand -----

Gas -----

Oil -----

Total Depth -----

PRODUCTION

1st 24 hrs. Nat. -----

1st 24 hrs. after shot -----

Gas ----- Cu. Ft.

Dry Hole -----

Abandoned -----

Date

JUL 15 1922 191

M. A. BENEAR Scout

Map No. Range 11 Sec. 1 Twp. 29 R. 5

Well No. 8 Lantz
Bredin & Ware Company

Contractor

COMPLETED

SECTION PLAT

----- Ft. from N. Line
200 Ft. from S. Line
 ----- Ft. from E. Line
1120 Ft. from W. Line

| | | | |
|---|--|--|--|
| | | | |
| 0 | | | |
| | | | |
| | | | |

Location -----

Rig up -----

Drilling and Remarks:

RECORD

Cased ----- in., ----- ft.
 Sand 2786-2812
 Gas -----
 Oil -----
 Total Depth 2812

PRODUCTION

1st 24 hrs. Nat. 150
 1st 24 hrs. after shot -----
 Gas ----- Cu. Ft.
 Dry Hole -----
 Abandoned -----

Date

AUG 13 1922

M. A. BENEAR

----- 191 -----

----- Scout