


Kansas

Map No. _____ Sec. 1 Twp. 29 R. 5

Well No. 10 Lantz Farm _____

Braden & Gore Company _____

NORTH

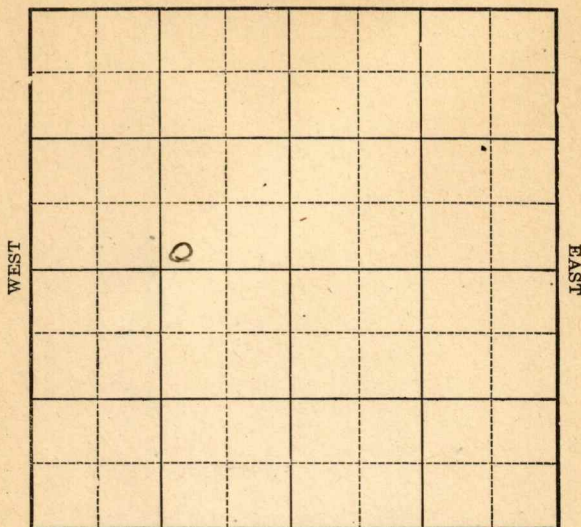

SOUTH

FIRST REPORT

Location _____

Rig Up _____

Drilling Remarks:

Drilling Remarks:

RECORD

PRODUCTION

Cased _____ in. _____ ft.

1st 24 hrs. Nat. _____

Sand _____

1st 24 hrs. after shot _____

Gas _____

Gas _____ cu. ft.

Oil _____

Dry Hole _____

Total Depth _____

Abandoned _____

Map No. _____ Sec. 1 Twp. 29 R. 5


Well No. 10 Jantz Farm
Bradent Yore Company

Ft. from N. Line

200 Ft. from S. Line

1120 Ft. from E. Line

Ft. from W. Line

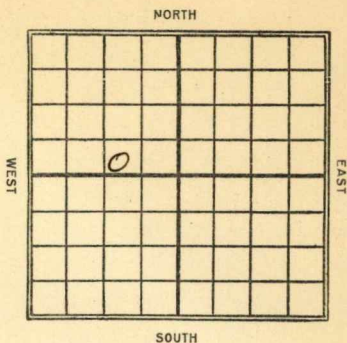

Date 1922

REPORT

10/26 Rig.
1923
1/6 Sand 2782-2813 - Shot 20
gts. 40 Bbs.

Map No. **KANSAS** ¹¹ Sec. 1 Twp. 29 R. 5Well No. 10 LentyBraden & Isaac Company

Contractor

FIRST REPORT

Ft. from N. Line

200 Ft. from S. Line1120 Ft. from E. Line

Ft. from W. Line

SECTION PLAT

Location ✓Rig up ✓

Drilling and Remarks:

RECORD

Cased _____ in., _____ ft.

Sand _____

Gas _____

Oil _____

Total Depth _____

PRODUCTION

1st 24 hrs. Nat. _____

1st 24 hrs. after shot _____

Gas _____ Cu. Ft.

Dry Hole _____

Abandoned _____

Date

OCT 26 1922

M. A. BENEAR

191

Scout

Map No. **KANSAS** Sec. 1 Twp. 29 R. 5

Well No. 10 Lenty
Bradley & Gore Company

Contractor

COMPLETED

SECTION PLAT

----- Ft. from N. Line

200 Ft. from S. Line

1120 Ft. from E. Line

----- Ft. from W. Line

	0		

RECORD

Location -----

Rig up -----

Drilling and Remarks:

shot 20 qt

Cased ----- in., ----- ft.

Sand -----

Gas -----

Oil 2782 - 2813

Total Depth 2813

PRODUCTION

1st 24 hrs. Nat. -----

1st 24 hrs. after shot 40

Gas ----- Cu. Ft.

Dry Hole -----

Abandoned -----

Date

JAN 6 1923

M. A. BENEAR

191

Scout