


Map No. K Sec. 1 Twp. 29 R. 5

Well No. 3 Meyers Farm
Wanda Oil Company

200 Ft. from N. Line
Ft. from S. Line
660 Ft. from E. Line
Ft. from W. Line

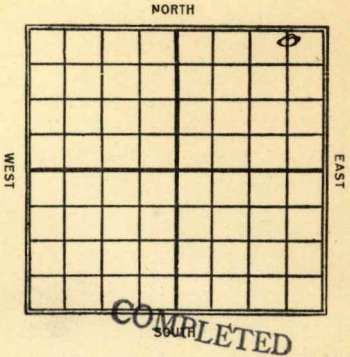

Date
1922

REPORT

1/3 11 lg 500'
2/4 SD 2400'
2/18 2740-2826 -
Shot 60 fts -
Shot 60 fts -
pumping 15 bbls

Map No. K11 Sec. 2 Twp. 29 R. 5

Well No. 3 Meyers
Wanda Company

Contractor

COMPLETED SECTION PLAT

200 Ft. from N. Line

_____ Ft. from S. Line

660' Ft. from E. Line

_____ Ft. from W. Line

			0

Location _____

Rig up _____

Drilling and Remarks:

sand { 2740
2826

shot 60 lbs
pumping
15 hrs.

RECORD

Cased _____ in., _____ ft.

Sand _____

Gas _____

Oil _____

Total Depth _____

PRODUCTION

1st 24 hrs. Nat. _____

1st 24 hrs. after shot _____

Gas _____ Cu. Ft.

Dry Hole _____

Abandoned _____

Date

FEB 18 1922

191

M. A. BENEAR


Scout

Map No. 11 Sec. 2 Twp. 29 R. 5

Well No. 3 Meyers Farm
Wanda oil Company

Date Started _____ Ft. from N 200 S 660 W line

NORTH Kansas

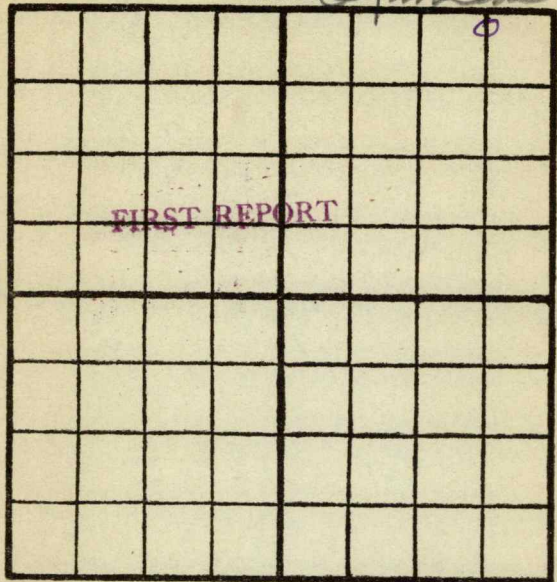

SOUTH

Cased _____ In. _____ Ft.	Production Remarks
Sand _____	
Pay { Gas _____	
Total Depth _____	

Condition of Well on this date _____

20' lgs. at 500'

M. A. BENEAR

Scout