


Kansas

Map No. _____ Sec. *1* Twp. *29* R. *25*

Well No. *9 Lentz* Farm _____

Braden & Gore Company _____

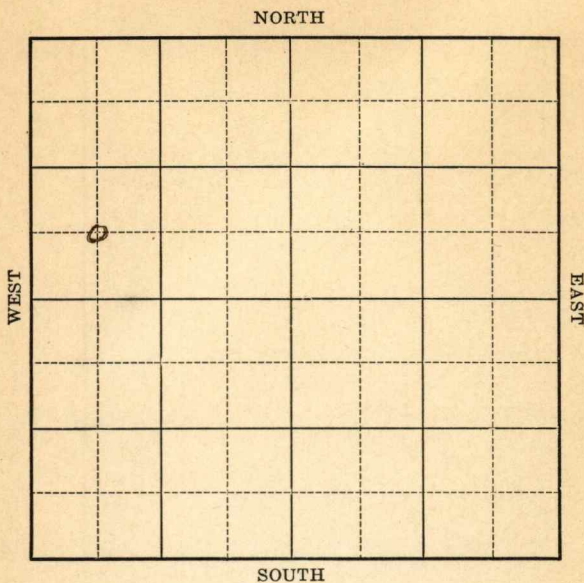

Location _____

Drilling Remarks:

RECORD

Cased _____ in. _____ ft.

Sand _____

Gas _____

Oil _____

Total Depth _____

Rig Up _____

Drilling Remarks:

PRODUCTION

1st 24 hrs. Nat. _____

1st 24 hrs. after shot _____

Gas _____ cu. ft.

Dry Hole _____

Abandoned _____

COMPLETED


Map No. _____ Sec. 1 Twp. 29 R. 5
Well No. # 9 Lentz Farm
Braden & Gore Company

_____ Ft. from N. Line

660 Ft. from S. Line

_____ Ft. from E. Line

660 Ft. from W. Line

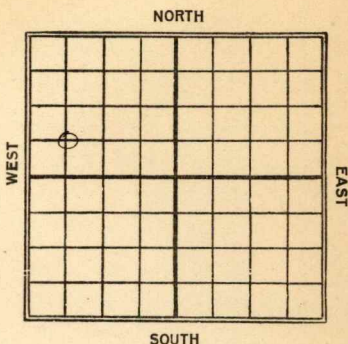

Date

REPORT

1/22

7/22

Rig
11/24 Sand 2807-2816 - Shot
7 gts. 50 lbs.

Map No. Kans 11 Sec. 1 Twp. 29 R. 5Well No. 9 LentsBraden & Sons Company

Contractor

FIRST REPORT

SECTION PLAT

Ft. from N. Line

660 Ft. from S. Line

Ft. from E. Line

660 Ft. from W. Line

0			

Location

Rig up

Drilling and Remarks:

Rig

RECORD

Cased _____ in., _____ ft.

Sand _____

Gas _____

Oil _____

Total Depth _____

PRODUCTION

1st 24 hrs. Nat. _____

1st 24 hrs. after shot _____

Gas _____ Cu. Ft.

Dry Hole _____

Abandoned _____

Date

JUL 22 1922

M. A. BENEAR

191

Scout

Map No. **KANSAS** Sec. *1* Twp. *29* R. *5*
Well No. *9 Lunt**Brandon & Gore* Company

Contractor

COMPLETED SECTION PLAT

Ft. from N. Line

660 Ft. from S. Line

Ft. from E. Line

660 Ft. from W. Line

<i>0</i>			
<i>0</i>			

Location

Rig up

Drilling and Remarks:

shot 7 gts.

RECORD

Cased in., ft.

Sand

Gas

Oil *2807-2816*Total Depth *2816*

PRODUCTION

1st 24 hrs. Nat.

1st 24 hrs. after shot *50*

Gas Cu. Ft.

Dry Hole

Abandoned

Date

M. A. BENEAR

NOV 24 1922

191

Scout