


Butler

DX 78-1

KANSAS

Section # 1 Township 29 Range 5E
Well No. #1 Maynard
Company Morrison Prod.

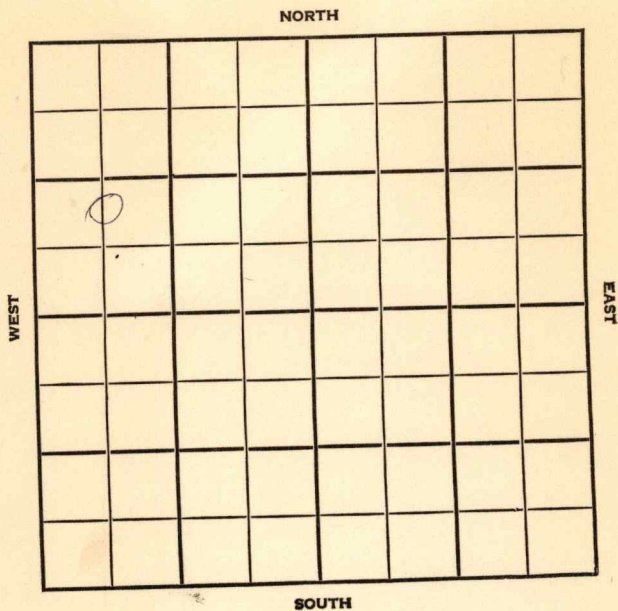

County Butler Elev. 1352
 Sec. 1 Twp. 29 Rge. 5E
 Company Morrison Prod.
 Farm Name Maynard No. 1

TOPS	DEPTH	LOG	DATUM	Loc. in Sec.
Anh.				C N/2 SW NW
Tr.				TWIN
Dg.				
Bl.				
L.				Geol.
K.C.				Contr.
B.K.C.				Morrison Tools
Ce.				
C.				Pool
M.				Fox-Bush
Mz.				
Me.				
V.				
S.				
S.				
A.				
R.				
Pe.				
G.				
T.D.				

Date Comm. 11-24-56
8" @ 93, drlg. 1300

~~29~~

FIRST REPORT

NOV 28 '56

County Butler Elev. 1352
 Sec. 1 Twp. 29 Rge. 5E
 Company Morrison Prod.
 Farm Name Maynard No. 1

TOPS	DEPTH	LOG	DATUM	Loc. in Sec.
Anh.				C N/2 SW NW
TP.				TWIN
H.				
Tr.				
Dg.				
Bl.				
L.				Geol.
K.C.				
B.K.C.				Contr.
Ce. <u>Bart'sd 2809</u>				Morrison Tools
C.				
M.				Pool
M.				Fox-Bush
K.				
Mz.				
Ma.				
V.				
S.				
S.				
A.				
R.				
Pe.				
G.				
TD	<u>2825</u>			COMPLETE

Date Comm. 11-24-56

8" @ 93, drlg. 1300 DEC 5 '56

5 1/2 2825 1100 WOC DEC 12 '56 MICT

DEC 19 '56

CO

DEC 26 '56

✓ JAN 2 '57 ✓

JAN 9 '57

CO DD 2827 TD PB

28170¢ Lots wtr. w.o. water
 Flood (will be oil well)