


State K11 County _____
 Sec. 2 Twp. 29 N-S; Rge. 5 E-W
 Well No. 1 Perisho Farm _____
Frank Wahn Company _____

NORTH

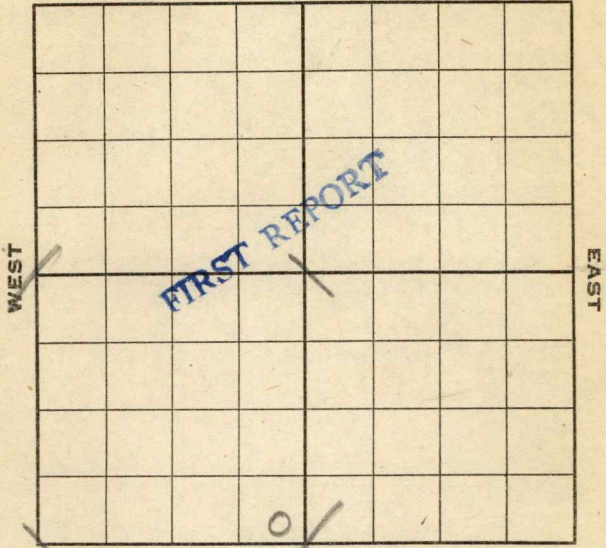

SOUTH

Location 2005-E Cased _____ in. _____ ft.
 Rig up _____ Mach. _____
 Drilling at _____
 Fishing at _____
 U. R. to _____
 S. D. at _____
 Natural production _____ Bbls. per _____ hours
 Pumping _____ Gas _____ Cu. ft. per 24 hours
 Gauge press. _____ lbs. Total depth _____
 Were samples collected _____

Remarks:

8/10 1920
 S. C. 9-1M-11-19. 29023

Pyle Scout

(Over)

Map No. K11 Sec. 2 Twp. 29 R. 5

Well No. 1 Perisha

Frank Kahn Company

Contractor

SECTION PLAT

COMPLETED

----- Ft. from N. Line

200 ----- Ft. from S. Line

200 ----- Ft. from E. Line

----- Ft. from W. Line

Location -----

Rig up -----

Drilling and Remarks:

RECORD

Cased ----- in., ----- ft.

Sand -----

Gas -----

Oil -----

Total Depth -----

PRODUCTION

1st 24 hrs. Nat. -----

1st 24 hrs. after shot -----

Gas ----- Cu. Ft.

Dry Hole 2879 -----

Abandoned -----

Date

10/21 19120

Pyle

Sc