

Butler

KANSAS

SECTION 2 TOWNSHIP 29 RANGE 5E

WELL NO. #8 Perisho

COMPANY Morrison Prod. Co.

NORTH

WEST

EAST

SOUTH

0

Butler

KANSAS

SEC. 2	TWP. 29	R. 5E
-----------	------------	----------


WELL NO. #8 Perisho FARM

COMPANY Morrison Prod. Co.

CONTRACTOR Morrison

Fox-Bush

_____ FT. FROM N. LINE
 _____ FT. FROM S. LINE
 100 _____ FT. FROM E. LINE
 _____ FT. FROM W. LINE

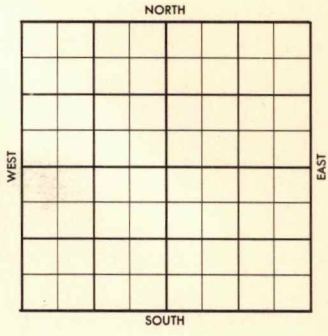

C E $\frac{1}{2}$ E $\frac{1}{2}$ SE

1956	ELEVATION 1377'	REPORT
------	--------------------	--------

5-23 MIR
 6-13 Comm. 5-24-56
 8" @96 w/25
 RUST
 CO 2816, $\$$ /2 bfph
 $\$$ 3 bo \neq 10 bwph
 Pop - est - 25 bopd \neq 100 bw
 Br. 2802-18', M. 2817',
 TD 2819'

COMPLETED

County Butler Elev. 1377
 Sec. 2 Temp. 29 Rge. 5E
 Company Morrison Prod. Co.
 Farm Name Perisho No. 8

TOPS	DEPTH	LOG	DATUM	Loc. in Sec.
Anh.				C E ¹ E ¹ SE
Tr.				100' EL
Dg.				
Bl.				
L.				Geol.
K.C.				Contr.
B.K.C.				Morrison
Ce. <u>BV</u>	<u>2812-18</u>			Pool
C.	<u>2817</u>			Fox-Bush
M.				<div style="border: 1px dashed black; padding: 10px; text-align: center;"> <p>COMPLETE</p> <p>JUN 13 '56</p> </div>
M.				
K.				
Mz.				
Mo.				
V.				
S.				
S.				
A.				
R.				
Pe.				
G.				
T.D.	<u>2819</u>			

Date Comm. M I R MAY 29 '56 JUN 6 '56 8" 96/75
Spd 5-24
2817
RUST JUN 13 '56 CO 2816 \$ 2 BDPH
Prod 3 BO + 10 BWPH P.P. test 25 BODD
+ 100 Bw

Co. No. Sec. T. R.

County Butler Elev. _____
 Sec. 2 Twp. 29 Rge. 5E
 Company Morrison Prod. Co.
 Farm Name Perisho No. 8

TOPS	DEPTH	LOG	DATUM
Anh.			
Tp.			
H.			
Tr.			
Dg.			
Bl.			
L.			
K.C.			
B.K.C.			
Ce.			
C.			
M.			
M.			
K.			
Mz.			
Mq.			
V.			
S.			
S.			
A.			
R.			
Pe.			
G.			
T.D.			

Loc. in Sec. C E $\frac{1}{2}$ E $\frac{1}{2}$ SE
100' EL

Geol. _____
 Contr. Morrison
 Pool Fox-Bush

FIRST REPORT		
MAY 23 '36		6

Date Comm. M I R

MAY 5 1936

(Large handwritten signature)

R.G.

Co.
Lse.
No.
Sec.
T.
R.