

KANSAS

Butler

Section 4 Township 29 Range 5EWell No. 1 CousinsCompany Shawver - Graham

Misc.

NORTH

|   |  |  |  |  |  |  |  |
|---|--|--|--|--|--|--|--|
|   |  |  |  |  |  |  |  |
|   |  |  |  |  |  |  |  |
|   |  |  |  |  |  |  |  |
| 0 |  |  |  |  |  |  |  |
|   |  |  |  |  |  |  |  |
|   |  |  |  |  |  |  |  |
|   |  |  |  |  |  |  |  |
|   |  |  |  |  |  |  |  |

WEST

EAST

SOUTH

KANSAS

Butler

Sec. 4 Twp. 29 R. 5E

Well No. #1 Cousins Farm

Shawver - Graham Company

Miscellaneous

         Ft. from N. Line

330'


         Ft. from S. Line

         Ft. from E. Line

100'

         Ft. from W. Line

SW NW

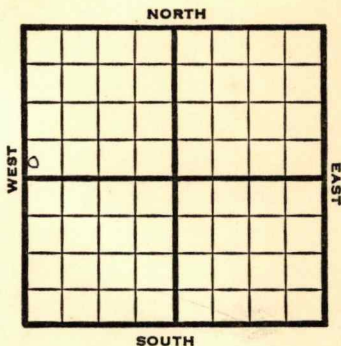

1948

**Eli 1308'**

R E P O R T

11/10

8" @ 85'

Drlg. 1262'

11/16

**KC 2216'**

Drlg. 2610'

11/23

TD 2781

4"@ 2781'

12/1

TD 2804'

**Bart 2796'**

4"@ 2781'

Pump 25 oil / 10 W Pot

38° Gr.

Comp

**COMPLETED**

Map No. \_\_\_\_\_ Sec. 4 Twp. 29 R. 5E

Well No. 1 Cousins

Shawver - Graham Company

IRST REPORT

Contractor

SW NW


SECTION PLAT

\_\_\_\_\_ Ft. from N. Line

330 Ft. from S. Line

\_\_\_\_\_ Ft. from E. Line

100 Ft. from W. Line

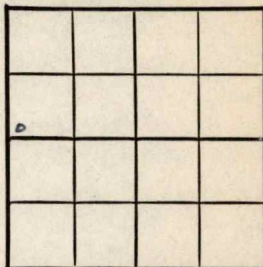

Butler County

Location \_\_\_\_\_

Rig up \_\_\_\_\_

Drilling and Remarks:

8" @ 85

drlg. 1262

RECORD

Cased \_\_\_\_\_ in., \_\_\_\_\_ ft.

Sand \_\_\_\_\_

Gas \_\_\_\_\_

Oil \_\_\_\_\_

Total Depth \_\_\_\_\_

PRODUCTION

1st 24 hrs. Nat. \_\_\_\_\_

1st 24 hrs. after shot \_\_\_\_\_

Gas \_\_\_\_\_ Cu. Ft.

Dry Hole \_\_\_\_\_

Abandoned \_\_\_\_\_

Date

NOV 10 1948 19

S. J. LEWIS Scout

Map No. 11 Sec. 4 Twp. 29 R. 5E

Well No. 1 Cousins

Shawver - Graham Company

**COMPLETE**

Contractor

SW NW


*E. 11308*  
**SECTION PLAT**

       Ft. from N. Line

330 Ft. from S. Line

       Ft. from E. Line

100 Ft. from W. Line

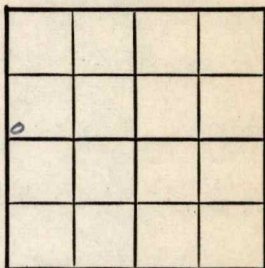

Butler County

Location       

Rig up       

Drilling and Remarks:

*Bar 2296*

*4" @ 2781*

*Run 25 oil + 10W*  
*BJ*

*2500*

**RECORD**

Cased        in.,        ft.

Sand       

Gas       

Oil       

Total Depth 2804

**PRODUCTION**

1st 24 hrs. Nat.       

1st 24 hrs. after shot       

Gas        Cu. Ft.

Dry Hole       

Abandoned       

Date

DEC 1 1948 19

S. J. LEWIS Scout