


Section 5 Township 29 Range 5E

Well No. 1 Harper

Company Franco Central

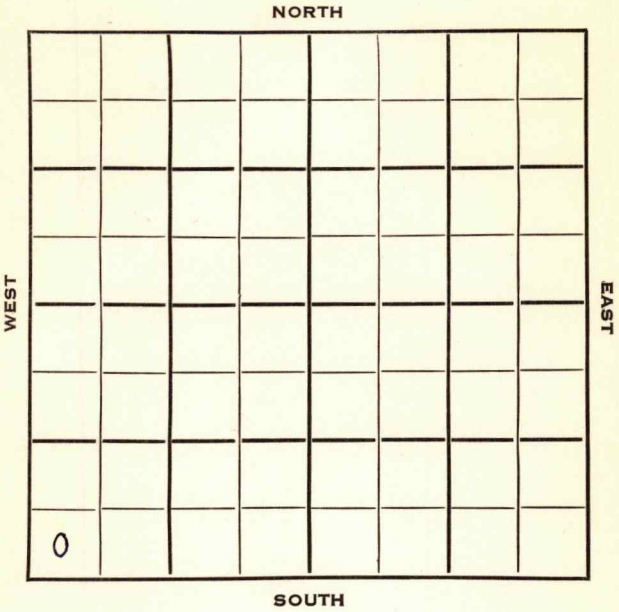

Butler
29

KANSAS ✓

5E

5

Sec. _____ Twp. _____ R. _____

Well No. #1 Harper Farm _____

Franco Central Company _____

White & Ellis Contractor _____


_____ Ft. from N. Line

330 Ft. from S. Line

_____ Ft. from E. Line

330 Ft. from W. Line

SW SW SW

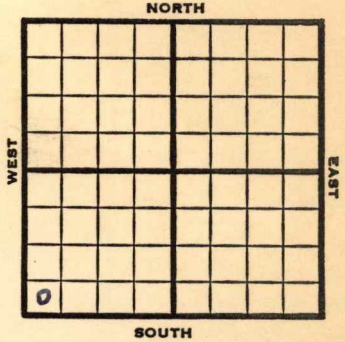

1953

Elev. 1297'

REPORT

4/8

Location

4/29

Spud 4-17-53 D & A TD 2852
 8" @ 104 KC 2227 B KC 2444
 Bart 2739 Miss 2838 TD 2852
 D & A

ABANDONED

