

KANSAS

Section 36 Township 16 Range 11W

Well No. #2 Breford


Company Eldorado Ref.

Kraft-Prusa pool

NORTH

WEST

EAST

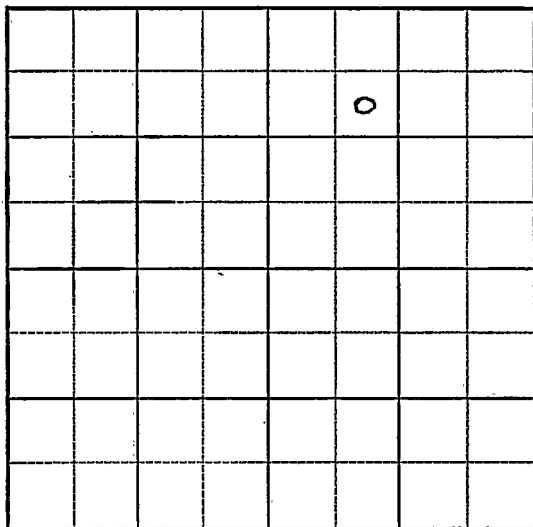

SOUTH

Barton

Sec. 36 Twp. 16 R. 11W

Well No. #2 Breford Farm

Eldorado Ref.

Company

Kraft-Prusa Pool (Sterling Drlg. Cont.)


990' Ft. from N. Line

 Ft. from S. Line

 Ft. from E. Line

990' Ft. from W. Line

SE NW NE

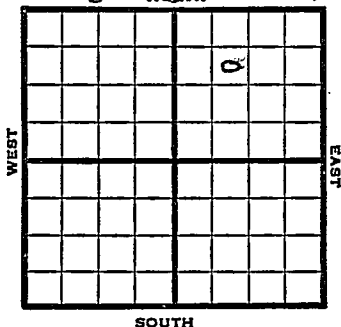

1949

Elev 1891' REPORT

8/17

8" @ 260'
Drlg. 1740'

8/24

Lansing 3634'
Drl.g 3252'

8/31

Arbuckle 3351'
TD 3365'
5" @ 3352'

10 qts 3359-61
8 gals oil PH

9/7

18 shots 3223-29
1000 acid wtr

9/14

Squeeze

9/21

"

9/28

"

10/5

TD 3600'
5"@ 3460'

10/12

"

10/19

TD 3600'
Arb. 3351'
5"@ 3352'

SWD

Aband.

ABANDONED

Map No. _____ Sec. 36 Twp. 16 R. 11W

Well No. 2 Breford

Eldorado Ref. _____ Company

Sterling Drlg. _____ Contractor

SE NW NE

FIRST REPORT
SECTION PLAT

990 Ft. from N. Line

_____ Ft. from S. Line

_____ Ft. from E. Line

990 Ft. from W. Line

Barton County

Location _____

Rig up _____

Drilling and Remarks:

8" @ 260

drlg. 1740

RECORD

Cased _____ in., _____ ft.

Sand _____

Gas _____

Oil _____

Total Depth _____

PRODUCTION

1st 24 hrs. Nat. _____

1st 24 hrs. after shot _____

Gas _____ Cu. Ft.

Dry Hole _____

Abandoned _____

Date

AUG 17 1949

19

S. J. LEWIS

Scout

Map No. _____ Sec. 36 Twp. 16 R. 11W

Well No. 2 Breford

Eldorado Ref. Company

ABANDONED

Contractor

SE NW NE


E1.1891
SECTION PLAT

990 Ft. from N. Line

_____ Ft. from S. Line

_____ Ft. from E. Line

990 Ft. from W. Line

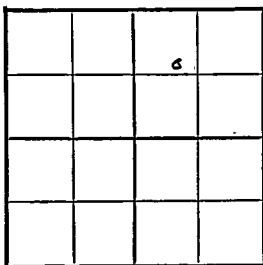

Barton County

RECORD

Location _____

Cased _____ in., _____ ft.

Rig up _____

Sand _____

Drilling and Remarks:

Gas _____

Oil _____

Total Depth 3600

PRODUCTION

1st 24 hrs. Nat. _____

1st 24 hrs. after shot _____

Gas _____ Cu. Ft.

Dry Hole _____

Abandoned _____

Date

OCT 19 1949

19

S. J. LEWIS

Scout