

Butler


FORM 51

KANSAS

Section 7 Township 29 Range 5E

Well No. #1 Fresh

Company White & Ellis

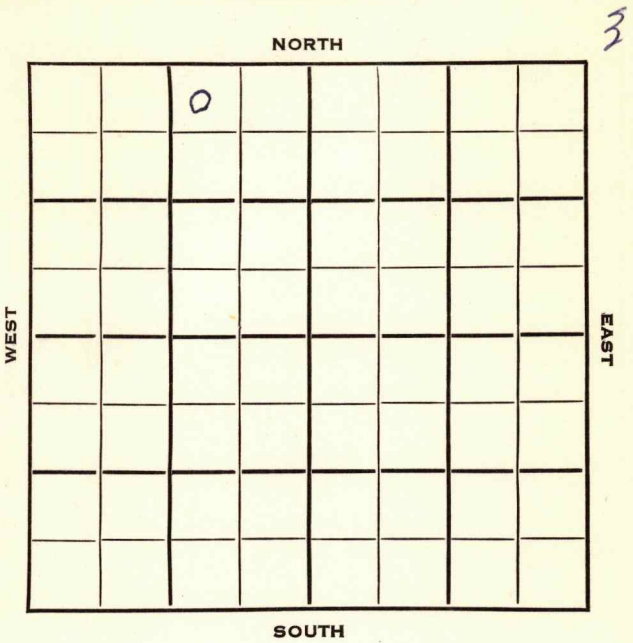

Butler

KANSAS

SEC.

TWP.

R.

7

29

5E

WELL NO.

#1 Fresh

FARM

COMPANY

White & Ellis

CONTRACTOR

White & Ellis

Muddy Creek Pool


NORTH

330 Ft. from N. Line

Ft. from S. Line

990 Ft. from E. Line

Ft. from W. Line

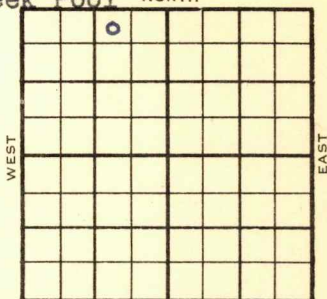

NW NE NW

SOUTH

ELEVATION

REPORT

1954

1259'

1/13

Spud 1-6-54

8" @ 95'

Dr1g 2675'

1/20

Spud 1-6-54

8" @ 95'

Miss 2818'

TD 2871'

D&A

ABANDONED

County	Butler		State	Kansas	
Sec.	7	(Blk.) (Twp.)	29	(Sur.) (Rge.)	5E Map No.
Operator	White & Ellis				
Well No.	1	Farm	Fresh		
Elev.	Location		NW NE NW		

0	330	Ft. From	N	Line	NW
	990	Ft. From	E	Line	Quarter
	1st. Report JAN 13 1954				
	Completion				
Remarks					
White & Ellis - Contr.					
Spudding Date 1-6-54					
Drlg. Data Muddy Creek Pool					
8" @ 95 drlg. 2675					

J. G. McGEHEE

County Butler State Kansas
 Sec. 7 (Blk.) 29 (Sur.) 5E Map No.
 Operator White & Ellis
 Well No. 1 Farm Fresh
 Elev. 1259 Location NW NE NW

		<u>D</u>				

ABANDONED

330 Ft. From N Line NW
990 Ft. From E Line Quarter

1st. Report

Completion JAN 20 1954

Remarks Muddy Creek Pool

White & Ellis - Contr.

Spudding Date 1-6-54

Drlg. Data

8" @ 95 Miss. 2818 TD 2871

D & A