

Well No. 1 Bredford

Company Eldorado Rfg.

Kraft-Prusa
NORTH


KANSAS

Barton

Sec. 36 Twp. 16 R. 11W

Well No. #1 Breford Farm

Eldorado Ref.

Company

Kraft-Prusa

 Ft. from N. Line


990'

 Ft. from S. Line

 Ft. from E. Line

330'

 Ft. from W. Line

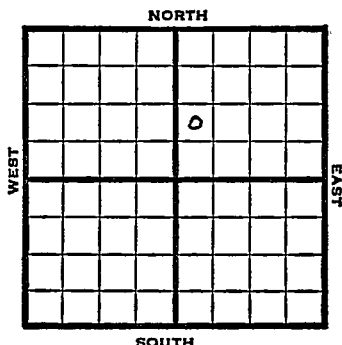

NW SW NE

1949

Elev 1908'

REPORT

5/4

8" @ 266'

Lans. 3033'

Drlg. 3233'

5/10

Arb. 3369-73'

TD 3373'

5" @ 3371

5/18

TD 3382'

500 acid

10 qts 3378-82'

2900' oil 12 hrs.

5/25

"

6/1

"

6/7

Pump 180 bbls oil 24 hrs.

6/15

Arb. 3369'

5" @ 3371'

TD 3382'

500 acid

10 qts

Pump 100 Oil Pot

420 Gr.

Comp

COMPLETED

Kansas,

Map No. _____ Sec. 36 Twp. 16 R. 11W

Well No. 1 Breford

Eldorado Ref. _____ Company

FIRST REPORT _____ Contractor

NW SW NE

SECTION PLAT

		o	

_____ Ft. from N. Line

990 _____ Ft. from S. Line

_____ Ft. from E. Line

330 _____ Ft. from W. Line

Barton County

Location _____

Rig up _____

Drilling and Remarks:

8" @ 266

Lans. 3033

drlg. 3233

RECORD

Cased _____ in., _____ ft.

Sand _____

Gas _____

Oil _____

Total Depth _____

PRODUCTION

1st 24 hrs. Nat. _____

1st 24 hrs. after shot _____

Gas _____ Cu. Ft.

Dry Hole _____

Abandoned _____

Date

MAY 4 1949

19

S. J. LEWIS

Scout

Barton

County

Kansas

State

Map No. 155 Sec. 36 Twp. 16 R. 11WWell No. 1 Breford

Eldorado Ref.

Company

COMPLETE

Contractor

NW SW NE

E 11908
SECTION PLAT

Ft. from N. Line

990 Ft. from S. Line

Ft. from E. Line

330 Ft. from W. Line

Kraft-Prusa Pool

Remarks:








Date

Scout

JUN 15 1949