

KANSAS


FORM 51 5M 10-41 PETROL

Barton

Section 36 Township 16 Range 11-W

Well No. #1 Kraft

Company J. J. Lynn

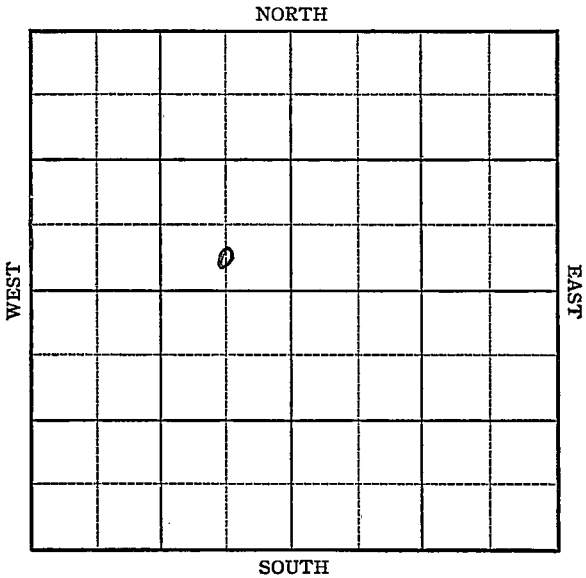

KANSAS


Barton

Sec. 36 Twp. 16 R. 11-WWell No. #1 Kraft FarmJ. J. Lynn Company

(Prusa)

 Ft. from N. Line330 Ft. from S. Line660 Ft. from E. Line Ft. from W. Line

Elev. 1908

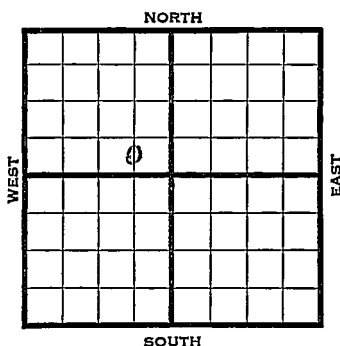

1941	REPORT
11/12	Surface hole.
11/20	10" - 270' Drlg. 2015'
11/26	Drlg. 3241'
12/4	Lans. 3032' Cong. 3334'
	Arb. 3357-70' T.D. 5" - 3356'
	RUST.
12/11	" " " "
12/18	2000 acid Pump 5 oil per hr.
12/24	Estimate 50 oil per hour.
12/31	" " "
1942	
1/8	" " "
1/14	Arb. 3357'
	5" - 3356'
	T.D. 3370'
	2000 acid.
	Potential 544 bbls., pump.
	42. Gravity
	COMPLETED

Map No. 155 Sec. 36 Twp. 16 R. 11WWell No. 1 KraftJ. J. Lynn CompanyFIRST REPORT Contractor

C SL SE NW

 Ft. from N. Line330 Ft. from S. Line660 Ft. from E. Line Ft. from W. Line

SECTION PLAT

	6		

PRUSA POOL

Location Rig up

Drilling and Remarks:

Surface Hole

RECORD

Cased in., ft.Sand Gas Oil Total Depth

PRODUCTION

1st 24 hrs. Nat. 1st 24 hrs. after shot Gas Cu. Ft.Dry Hole Abandoned

Date

NOV 12 1941 19

S. J. LEWIS

Scout

Map No. 55 Sec. 36 Twp. 16 R. 11WWell No. 1 KraftJ. J. Lynn

Company

COMPLETED

Contractor

C SL SE NW

 Ft. from N. Line330 Ft. from S. Line660 Ft. from E. Line Ft. from W. Line

SECTION FLAT

	0		

PRUSA POOL

Location Rig up

Drilling and Remarks:

Cr 83357
5" @ 3356
2000 acid
Pump 544 Pst.

42 0/2

RECORD

Cased in., ft.Sand Gas Oil Total Depth 3320

PRODUCTION

1st 24 hrs. Nat. 1st 24 hrs. after shot Gas Cu. Ft.Dry Hole Abandoned

Date

JAN 14 1942 19

S. J. LEWIS Scout