


Section 36 Township 16 Range 11W

Well No. #1-1/4"
#4 Kraft

Company J. J. Lynn

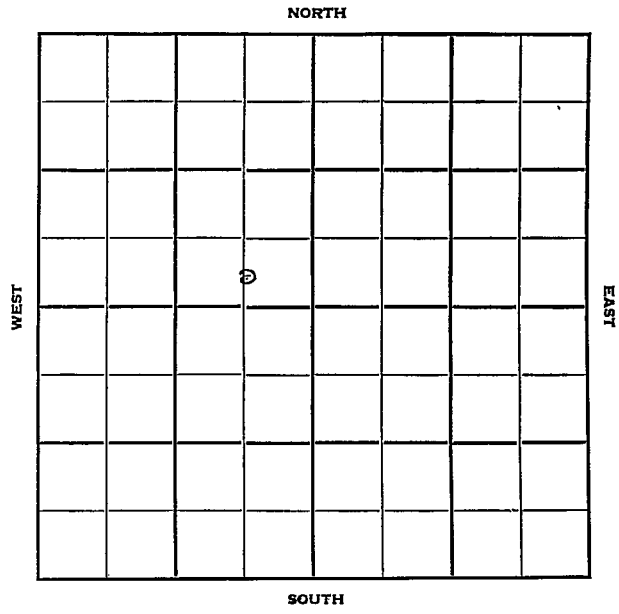

Sec. 36 Twp. 16 R. 11W ✓

Well No. #4 Kraft "A" Farm

J. J. Lynn Company

Sterling Drlg. - Contr. Contractor
Kraft-Prusa Pool


_____ Ft. from N. Line

330' Ft. from S. Line

570' Ft. from E. Line

_____ Ft. from W. Line

C S L SE NW

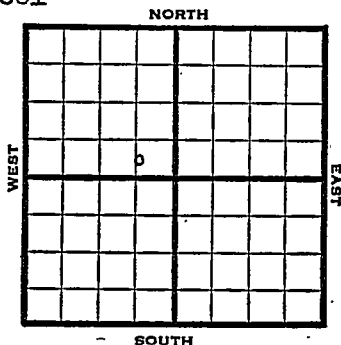

1950

Elev 1910 REPORT

10/25

Spud 10-21-50
8-5/8" @ 256'
Anhy 700-30.
Drlg. 925'

11/8

8 5/8" @ 256
Anhy 700-30 Heeb 2942
Lans 3041
DST 3235-51 opn 1 hr rec 35' mud & SW
Cong 3349 Arb 3375
TD 3400
D&A

ABANDONED

County Barton State Kansas

Sec. 36 (Blk. Twp.) 16 (Sur. Rge.) 11W Map No.

Operator J. J. Lynn

Well No. 4 Farm Kraft

Elev. 1910 Location C S L SE NW

330 Ft. From S Line NW

570 Ft. From E Line Quarter

1st. Report OCT 25 1950

Completion _____

Remarks _____

Sterling Drig. - Contr.

Spudding Date 10-21-50

Drig. Data Kraft-Prusa Pool

8 5/8" @ 256 Any 700-30 drig. 925

Map No. _____ Sec. 36 Twp. 16 R. 11W

Well No. 1 Kraft "A"

J. J. Lynn Company

CORRECTION

Contractor

C S L SE NW

SECTION PLAT

_____ Ft. from N. Line

330 Ft. from S. Line

570 Ft. from E. Line

_____ Ft. from W. Line

Barton County

RECORD

Location _____

Rig up _____

Drilling and Remarks:

Cased _____ in., _____ ft.

Sand _____

Gas _____

Oil _____

Total Depth _____

Reported

#4 Kraft

PRODUCTION

1st 24 hrs. Nat. _____

1st 24 hrs. after shot _____

Gas _____ Cu. Ft.

Dry Hole _____

Abandoned _____

Date

NOV 1 1950 19 _____

J. E. TYRA Scout

County Barton State Kansas

Sec. 36 (Blk. 16 (Sur. Rge.) 11W Map No.

Operator J. J. Lynn

Well No. 1A Farm Kraft

Elev. 1910 Location C S L SE NW

330 Ft. From S Line NW

570 Ft. From E Line Quarter

Ist. Report

Nov 8 1950

Completion

Remarks Kraft-Prusa Pool

Sterling Drlg. - Contr.

Spudding Date 10-21-50

ABANDONED

Drlg. Data D & A TD 3400

8 5/8" @ 256 Anhy 700-30 Heeb. 2942

Lans. 3041 DST 3235-51 open 1 hr.

Rec. 35' mud & sw Cong. 3349 Arb. 3375

TD 3400 D & A

Dec
County
Co
KB