

KANSAS


FORM 51 5M 1-42 PETROL

Woodson

Section 28 Township 25 Range 14-E

Well No. #6 Enloe

Company Bird Henley et al

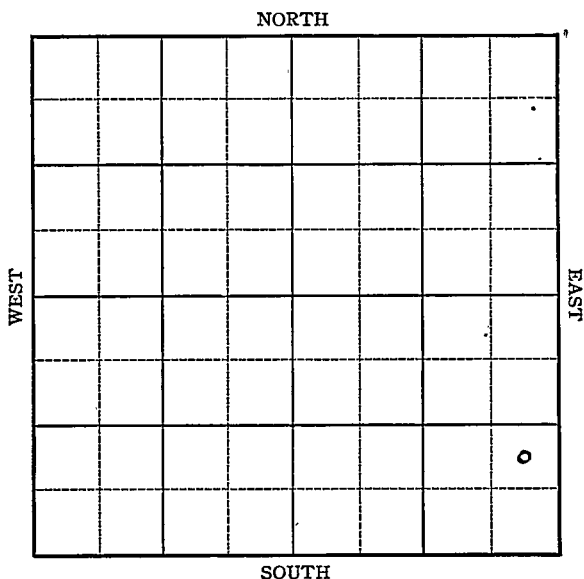

KANSAS


Woodson

Sec. 28 Twp. 25 R. 14-E

Well No. #6 Enloe Farm

Bird Henley et al Company

NORTH

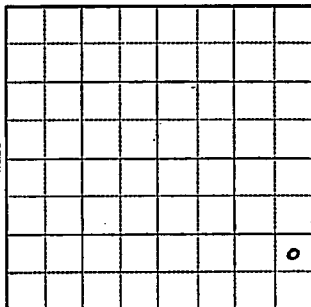

SOUTH

 Ft. from N. Line

990 Ft. from S. Line

330 Ft. from E. Line

 Ft. from W. Line

1944

R E P O R T

1/19

10" @ 650
8-" @ 1063
6" @ 1446'
Bart Sand 1456-74
SO
TD 1530
Pump 150 Pot.
CPT.

FIRST REPORT



COMPLETED

KANSASMap No. Sec. 28 Twp. 25 R. 14EWell No. 6 EnloeBird Henley et al. Company

FIRST REPORT

and

Contractor

COMPLETED

NE SE SE

SECTION PLAT

			o

 Ft. from N. Line990 Ft. from S. Line330 Ft. from E. Line Ft. from W. Line

Miscellaneous

Location Rig up

Drilling and Remarks:

10" - 650

8" - 1063

6" - 1446

Bar t Sand

1456-74

SO TD 1530

Pump 150 Pot.

Cpt.

RECORD

Cased in., ft.Sand Gas Oil Total Depth 1530

PRODUCTION

1st 24 hrs. Nat. 1st 24 hrs. after shot Gas Cu. Ft.Dry Hole Abandoned

Date

JAN 19 1944

19

S. J. LEWIS Scout