

# KANSAS

Barton


FORM 51 5M 10-41 PETROL

Section 36 Township 16 Range 11-W

Well No. 1 Smith

Company J. J. Lynn

Prusa Pool

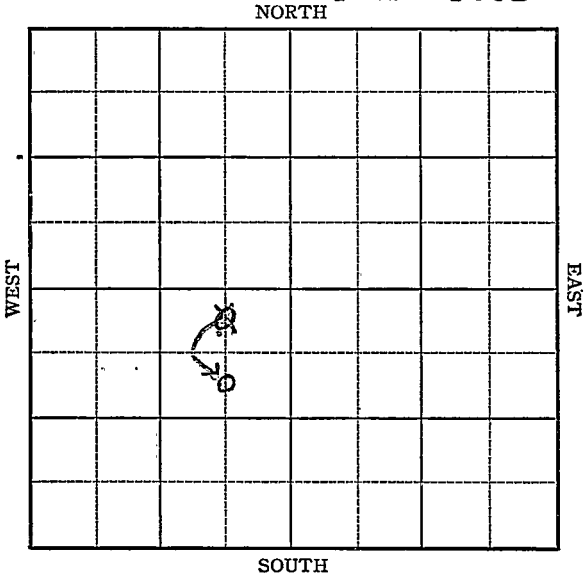



1942

3/25

Arb. 3350'

5" - 3350 $\frac{7}{8}$ '

T.D. 3373'

5000 acid.

Potential 367 bbls., pump.

43.6 Gravity

**COMPLETED**

Map No. 55 Sec. 36 Twp. 16 R. 11WWell No. 1 SmithJ. J. Lynn CompanyFIRST REPORTS Contractor

C NL NE SW

## SECTION PLAT

330 Ft. from N. Line

\_\_\_\_\_ Ft. from S. Line

660 Ft. from E. Line

\_\_\_\_\_ Ft. from W. Line


PRUSA POOL

## RECORD

Location \_\_\_\_\_

Cased \_\_\_\_\_ in., \_\_\_\_\_ ft.

Rig up \_\_\_\_\_

Sand \_\_\_\_\_

Drilling and Remarks: ^

Gas \_\_\_\_\_

Oil \_\_\_\_\_

Derrick

Total Depth \_\_\_\_\_

## PRODUCTION

1st 24 hrs. Nat. \_\_\_\_\_

1st 24 hrs. after shot \_\_\_\_\_

Gas \_\_\_\_\_ Cu. Ft.

Dry Hole \_\_\_\_\_

Abandoned \_\_\_\_\_

Date

JAN 7 1942 19S. J. LEWIS Scout



Barton

KANSAS

Map No. 55 Sec. 36 Twp. 16 R. 11W

Well No. 1 Smith

J. J. Lynn Company

**COMPLETED** Contractor

SECTION PLAT


C SL NE SW  
990 Ft. from N. Line

Ft. from S. Line

660 Ft. from E. Line

Ft. from W. Line

PRUSA POOL

Location \_\_\_\_\_

Rig up \_\_\_\_\_

Drilling and Remarks:

*CR 3350  
5" @ 3350 1/2  
5000 acid  
Pump 367 P.D.*

*43 6/8*

RECORD

Cased \_\_\_\_\_ in., \_\_\_\_\_ ft.

Sand \_\_\_\_\_

Gas \_\_\_\_\_

Oil \_\_\_\_\_

Total Depth 3373

PRODUCTION

1st 24 hrs. Nat. \_\_\_\_\_

1st 24 hrs. after shot \_\_\_\_\_

Gas \_\_\_\_\_ Cu. Ft.

Dry Hole \_\_\_\_\_

Abandoned \_\_\_\_\_

Date

MAR 25 1942 19

S. J. LEWIS Scout