


Section 7 Township 29 Range 5E

Well No. #2 Perisho

Company Sunray Oil Company

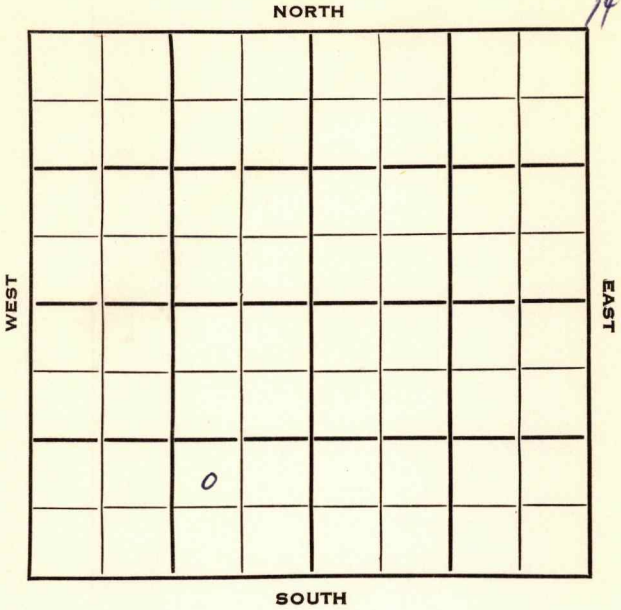

Butler

Sec. 7 Twp. 29 R. 5E

Well No. #2 Perisho Farm

Sunray Oil Company

Wakefield - Contr. Contractor


Muddy Creek Pool

Ft. from N. Line

990 Ft. from S. Line

990 Ft. from E. Line

Ft. from W. Line

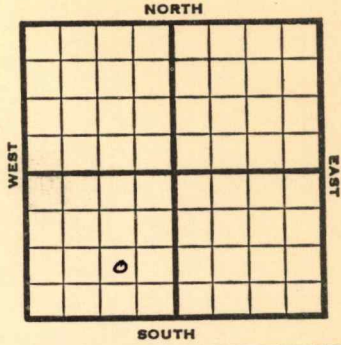

NW SE SW

1953 Elev. 1299' REPORT

2/18 RUR

3/11 Spud 2-19-53
 Oil Well
 TD 2807
 8" @ 72
 Bart 2782
 TD 2796
 5" @ 2793
 DD 2807
 36 goph Hydro
 Comp. 50 bopd

COMPLETED

