



Butler

KANSAS

SEC. 7	TWP. 29	R. 5E
-----------	------------	----------

WELL NO. #6 Fresh FARM

COMPANY Butler Drlg.

CONTRACTOR Co. Tools

Muddy Creek


\_\_\_\_\_ Ft. from N. Line

605 \_\_\_\_\_ Ft. from S. Line

\_\_\_\_\_ Ft. from E. Line

1798 \_\_\_\_\_ Ft. from W. Line

SW SE NW

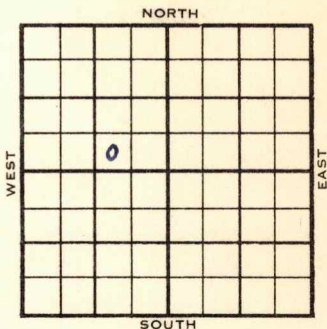

1955	ELEVATION 1254'	REPORT
------	--------------------	--------

8/17 MICT

11-23 Comm. 8-28-55  
 10" @ 1085  
 8" @ 1860  
 5 1/2" @ 2761  
 CO to 2759  
 20 / 2746-50 frac  
 Comp. 7 bopd  
 L. 1862  
 K.C. 2211  
 Bartl sd. 2746-50  
 TD 2761'

COMPLETED

County Butler Elev. \_\_\_\_\_  
 Sec. 7 Twp. 29 Rge. 5E  
 Company Butler Drig.  
 FarmName Fresh No. 6

TOPS	DEPTH	LOG	DATUM	Loc. in Sec.
Anh.				SW SE NW
Tr.				605' SL
H.				1798' WL
Tr.				
Dg.				
Bl.				
L.				Geol. _____
K.C.				Contr. _____
B.K.C.				
Ce.				Co. tools
C.				
M.				Pool
M.				Muddy Creek
K.				
Mz.				
Me.				
V.				
S.				
S.				
A.				
R.				
PE.				
G.				
T.D.				

NOV 17 '58  
 10  
 FIRST REPORT

Date Comm. MICT

Co.  
 Lse.  
 No.  
 Sec.  
 T.  
 R.

County Butler Elev. 1254  
 Sec. 7 Twp. 29 Rge. 5E  
 Company Butler Drilg.  
 Farm Name Fresh No. 6

TOPS	DEPTH	LOG	DATUM
Anh.			
Tp.			
H.			
Tr.			
Dg.			
Bl.			
L.	<u>1862</u>		<u>608</u>
K.C.	<u>2211</u>		<u>957</u>
BKE Part / sd.	<u>2746-50</u>		<u>1992</u>
Ce.			
C.			
M.			
M.			
K.			
Mz.			
Me.			
V.			
S.			
S.			
A.			
R.			
PE.			
G.			
T.D.	<u>2761</u>		

Loc. in Sec. \_\_\_\_\_  
 SW SE NW  
 605' SL  
 1798' WL  
 Geol. \_\_\_\_\_  
 Contr. \_\_\_\_\_  
 Co. tools \_\_\_\_\_  
 Pool \_\_\_\_\_  
 Muddy Creek  

O		

COMPLETE

Date Comm. 8-28-55 NOV 2 3 1955

10" @ 1085    8" @ 1860    5 1/2" @ 2761

CO to 2759    20/ 2746-50    frac

Comp. 7 bopd

Co. Lse. No. Sec. T. R.