FORM 51 Butler


KANSAS

Section 7 Township 29 Range 5E

Well No. #4 Perisho

Company Sunray Oil Company

13

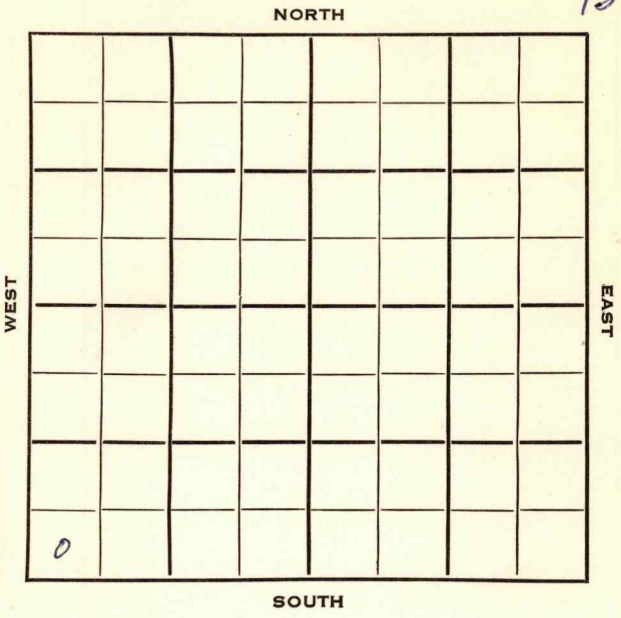

FORM 252-B

Butler KANSAS ✓

Sec. 7 Twp. 29 R. 5 E

Well No. # 4 Perisho Farm

Sunray Oil Company

Wakefield Contractor


_____ Ft. from N. Line

330 Ft. from S. Line

_____ Ft. from E. Line

330 Ft. from W. Line

SW SW SW

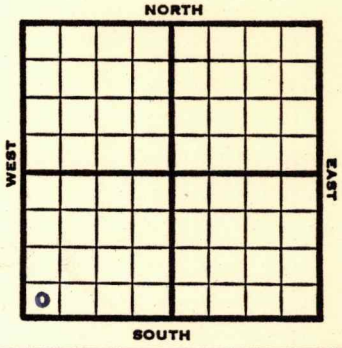

1953	Elev. 1304' REPORT
3/25	RUR
4/8	Spud 3-26-53 D&A TD 2890 8" @ 77 Bart 2798 TD 2890 D&A

ABANDONED

FORM 275 FOR SALE BY KANSAS BLUE PRINT CO.


County Butler State Kansas

Sec. 7 (Blk. Twp.) 29 (Sur. Rge.) 5E Map No.

Operator Sunray Oil

Well No. 4 Farm Perisho

Elev. Location SW SW SW

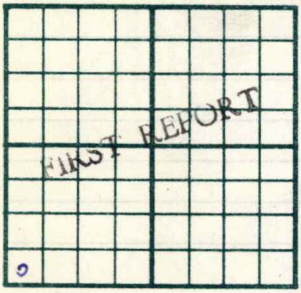

330 Ft. From S Line SW

330 Ft. From W Line Quarter

1st. Report MAR 25 1953

Completion

Remarks

Wakefield - Contr.

Spudding Date

Drlg. Data

R U R

J. G. McGEHEE

FORM 275 FOR SALE BY KANSAS BLUE PRINT CO.

County Butler State Kansas

Sec. 7 (Blk. Twp.) 29 (Sur. Rge.) 5E Map No.

Operator Sunray Oil

Well No. 4 Farm Perisho

Elev. 1304 Location SW SW SW



330 Ft. From S Line SW

330 Ft. From W Line Quarter

1st. Report

Completion APR 8 1953

Remarks

Wakefield - Contr.

Spudding Date 3-26-53

Drlg. Data D & A TD 2890

8" @ 77 Bart. 2798 TD 2890

D & A

J. G. McGEHEE