


Section 1 Township 16 Range 12-W

Well No. #1 Woydziak

Company Tom Palmer
Kraft-Prusa

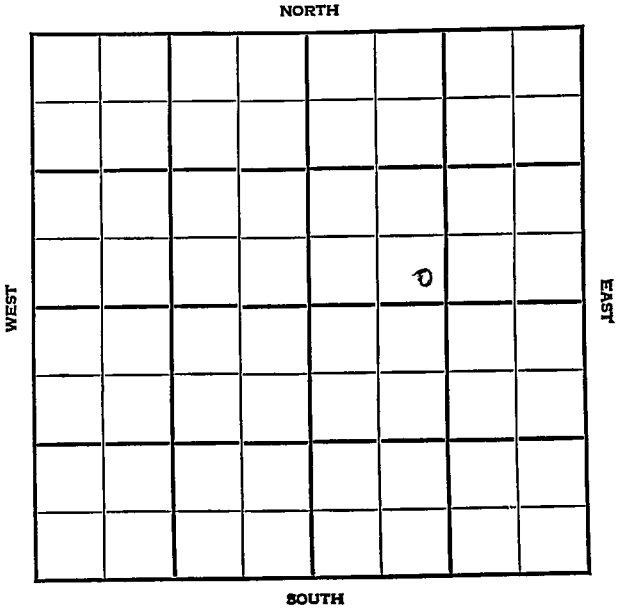

Barton

KANSAS

Sec. 1 Twp. 16 R. 12W

Well No. #1 Woydziak Farm

Tom Palmer

Company

Kraft-Prusa

 Ft. from N. Line

330'


 Ft. from S. Line

 Ft. from E. Line

990'

 Ft. from W. Line

SE - SW ^W NE

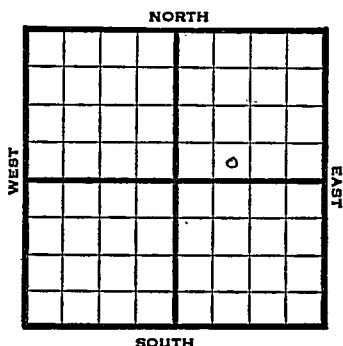

1948

Elev. 1868' REPORT

6/23

Location

6/29

Drlg. 1950'

7/8

Lans. 3027'

Congl. 3307'

TD 3345 in Cong.

ABANDONED

Map No. _____ Sec. 1 Twp. 16 R. 12WWell No. 1 WovdziakTom Palmer Company

FIRST REPORT

Contractor

SE SW NE

SECTION PLAT

 Ft. from N. Line330 Ft. from S. Line Ft. from E. Line990 Ft. from W. LineBarton County

RECORD

Location XCased in., ft.Rig up Sand

Drilling and Remarks:

Gas Oil Total Depth

PRODUCTION

1st 24 hrs. Nat. 1st 24 hrs. after shot Gas Cu. Ft.Dry Hole Abandoned

Date

JUN 23 1948 19 S. J. LEWIS Scout

Map No. 55 Sec. 1 Twp. 16 R. 12W

Well No. 1 Woydziak

Tom Palmer Company

ABANDONED

Contractor

SE SW NE

E 11868
SECTION PLAT

		0	

 Ft. from N. Line

330 Ft. from S. Line

 Ft. from E. Line

990 Ft. from W. Line

Barton County

Location

Rig up

Drilling and Remarks:

Have 3027

Comp 3307

RECORD

Cased in., ft.

Sand

Gas

Oil

Total Depth 3345 in Comp

PRODUCTION

1st 24 hrs. Nat.

1st 24 hrs. after shot

Gas Cu. Ft.

Dry Hole

Abandoned

Date

JUL 8 1948 19

S. J. LEWIS Scout