


Section 1 Township 16S Range 12W

Well No. #1 Schauf "A" (KGS DRL)

Company Bridgeport

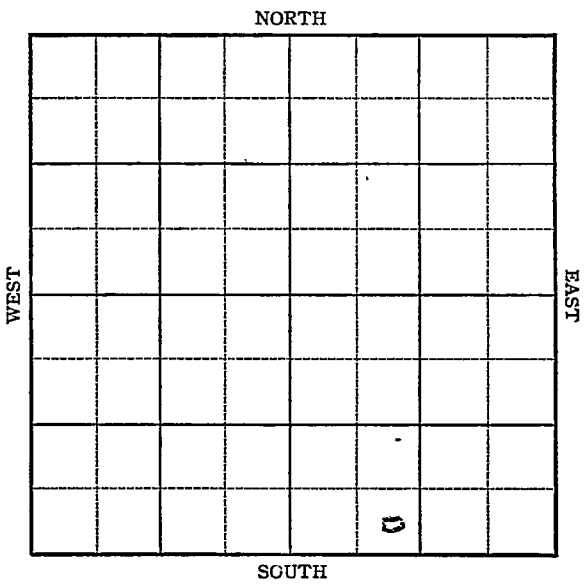

Sec. 1 Twp. 16 R. 12W

Well No. #1 Schauf (A) (KGS DRL) Farm

Bridgeport

Company


Kraft-Prusa

_____ Ft. from N. Line

330 Ft. from S. Line

_____ Ft. from E. Line

990 Ft. from W. Line

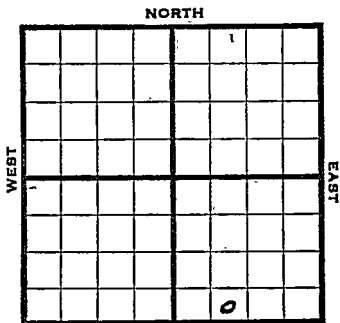

SE SW SE Elev. 1867

1945

R E P O R T

3/21 Location
 3/29 8" @ 290
 Drlg. 750
 4/5 Topeka 2667
 Heebner 2922
 Lans 3027-3161 fsg.
 4/12 Arb 3304-3307 TD
 5" @ 3305' RUST
 4/20 Arb 3302 corrected
 5" @ 3303
 TD 3307
 Swab 12½ oil per hr.
 4/27 " " " " " " "
 5/2 Arb 3302
 5" @ 3303
 TD 3307
 Edro. Pot. 1999
 Grav. 42.4

COMPLETED

Pool Name Kraft-Prusa

Map No. 55 Sec. 1 Twp. 16 R. 12W

Well No. 1 Schauf (A) (KGS DRL)

Bridgeport Company

FIRST REPORT

Contractor

SE SW SE

SECTION PLAT

 Ft. from N. Line

330 Ft. from S. Line

 Ft. from E. Line

990 Ft. from W. Line

Barton

Location X

Rig up

Drilling and Remarks:

RECORD

Cased in., ft.

Sand

Gas

Oil

Total Depth

PRODUCTION

1st 24 hrs. Nat.

1st 24 hrs. after shot

Gas Cu. Ft.

Dry Hole

Abandoned

Date

MAR 21 1945

19

S. J. LEWIS

Scout

Kansas Pool Name Kraft-PrusaMap No. 55 Sec. 1 Twp. 16 R. 12WWell No. 1 Schauf (A) (KGS DRL)Bridgeport Company**COMPLETED**

Contractor

SE SW SE

E11867
SECTION PLAT Ft. from N. Line330 Ft. from S. Line Ft. from E. Line990 Ft. from W. Line

Barton County

Location Rig up

Drilling and Remarks:

Cor 3302.5" CO 3303Eclw 8/199942 1/2

RECORD

Cased in., ft.Sand Gas Oil Total Depth 3302

PRODUCTION

1st 24 hrs. Nat. 1st 24 hrs. after shot Gas Cu. Ft.Dry Hole Abandoned

Date

MAY 2 1945 19S. J. LEWIS Scout