

Section 2 Township 16 Range 12W

Well No. #1 Schauff "B"


Company Winkler-Kock

Beaver Pool

NORTH

WEST

EAST

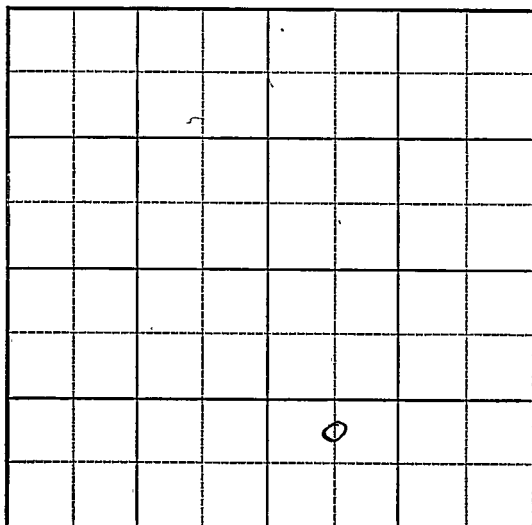


SOUTH

Sec. 2 Twp. 16 R. 12-18

Well No. #1 Schauf "B" Farm

Winkler-Kock Company

NORTH

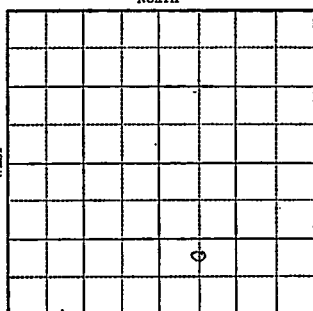

SOUTH

_____ Ft. from N. Line

990 Ft. from S. Line

_____ Ft. from E. Line

660 Ft. from W. Line

Elev. 1887

1943

R E P O R T

12-22 8" at 274'

Anhy 755

1440' Drlg.

12/29 Lans 3159

TD 3310 SD

1944

1-5 Lans 3070 corrected

Cong 3334

Arb 337-40 TD

5" @ 3338 RUST

1-12

" "

1/19

TD 3347-135' oil in 4 hrs.

1000 acid.

1/26

4500 acid

Swb 2 oil per hr.

2/2

" "

2/8

Pump 25 oil in 24 hrs.

2/15

" " " "

OVER

1944

2/23

5" @ 3338

Arb 3337

TD 3347

5500 acid

Pump 40 Pot.

Gravity 40

COMPLETED

KANSAS

Map No. 55 Sec. 2 Twp. 16 R. 12WWell No. 1 Schauf "B"

Winkler-Kock


Company

FIRST REPORT

Contractor

C N L SW SE

SECTION PLAT

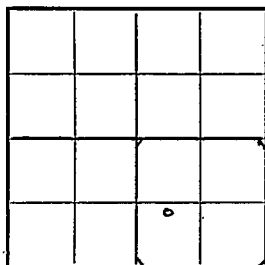

Ft. from N. Line

990

Ft. from S. Line

Ft. from E. Line

660

Ft. from W. Line

Beaver Pool

Location

Rig up

Drilling and Remarks:

8" - 274

Anhy. 755

1440

RECORD

Cased _____ in., _____ ft.

Sand _____

Gas _____

Oil _____

Total Depth _____

PRODUCTION

1st 24 hrs. Nat. _____

1st 24 hrs. after shot _____

Gas _____ Cu. Ft.

Dry Hole _____

Abandoned _____

Date

DEC 22 1943

19

S. J. LEWIS

Scout

Barton

Map No. 55 Sec. 2 Twp. 16 R. 12W

Well No. 1 Schauf "B"

Winkler-Kock

Company

COMPLETED

Contractor

C N L SW SE

SECTION PLAT

Ft. from N. Line

990

Ft. from S. Line

Ft. from E. Line

660

Ft. from W. Line

Feltes Pool North

Location

Rig up

Drilling and Remarks:

Art 3337

5' @ 3338.

5500 Acid

Pump 40 Pst

40 2 Gr

RECORD

Cased _____ in., _____ ft.

Sand _____

Gas _____

Oil _____

Total Depth 3342

PRODUCTION

1st 24 hrs. Nat. _____

1st 24 hrs. after shot _____

Gas _____ Cu. Ft.

Dry Hole _____

Abandoned _____

Date

FEB 23 1944

19

S. J. LEWIS

Scout