



Leavenworth  
 County ~~Pierce~~ <sup>Platte</sup> No. 1  
 Farm

22  
 Range  
 11 S  
 Township  
 31  
 Section

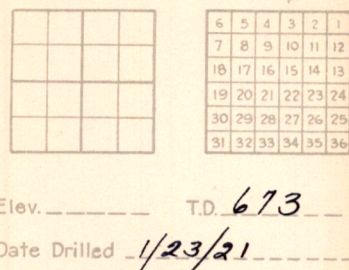

Elev. \_\_\_\_\_ T.D. 673  
 Date Drilled 1/23/21  
 Correlation by \_\_\_\_\_

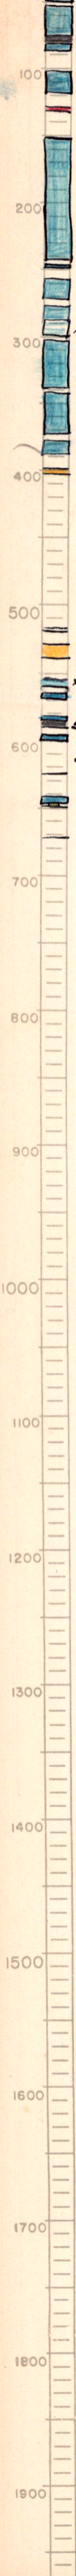

clay  
 sh.  
 x  
 x  
 sh.  
 dk.  
 gas  
 T.D. 673