


Section 28 Township 25 Range 14E

Well No. #13 Tipton

Company C. L. Sheedy

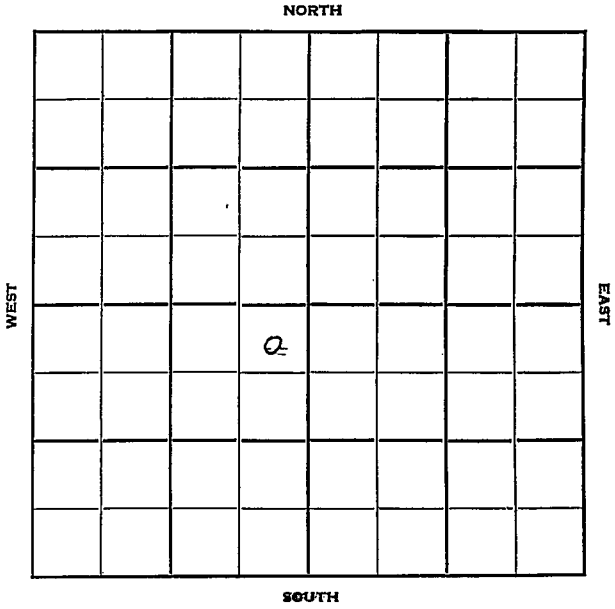

Woodson

KANSAS ✓

Sec. 28 Twp. 25 R. 14E

Well No. #13 Tipton Farm

C. L. Sheedy Company

Contractor


Bates Pool
30' Ft. from N. Line

_____ Ft. from S. Line

330' Ft. from E. Line

_____ Ft. from W. Line

NE NE SW

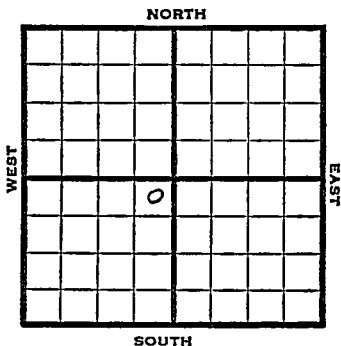

1951

REPORT

1/17

Miss 1530 TD 1544 D&A

FIRST REPORT
ABANDONED

