

Barton County

KANSAS

FORM 51 10M 8-47

Section 4 Township 16 Range 12W

Well No. 1 Casey

Company W. L. Hartman

NORTH

		0					

SOUTH

WEST

EAST

KANSAS

Barton


Sec. 4 Twp. 16 R. 12-WWell No. #1 Casey FarmW. L. Hartman Company

Kraft-Prusa

NORTH

330' Ft. from N. Line Ft. from S. Line990 Ft. from E. Line-990' Ft. from W. Line

NW NE NW

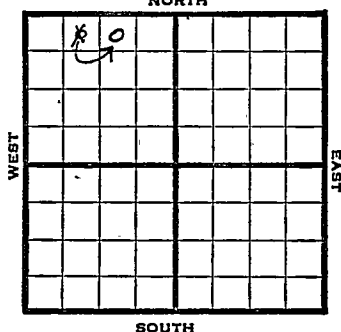

1947 Elev. 1867' REPORT

12/10	8" @ 201' WOC
12/17	Drlg. 2725'
12/30	Lansing 3042' Arbuckle 3317' TD 3317½' 5" @ 3317'
1948 1/7	"
1/14	"
1/21	TD 3324' SSO
1/26	PG 3320' 500 acid Pipe Collopped
2/4	"
2/11	TD 3336' 800' oil 6 hrs.
2/18	"
2/25	"
3/3	Arbuckle 3317' 5" @ 3317' Pump 52 Rot Total Depth 3336' Gr. 390 COMPLETED

Map No. 55 Sec. 4 Twp. 16 R. 12W

Well No. 1 Casey

W. L. Hartman Company

FIRST REPORT Contractor

NW NE NW

SECTION PLAT

330 Ft. from N. Line

 Ft. from S. Line

 Ft. from E. Line

990 Ft. from W. Line

0			

Barton County

Location

Rig up

Drilling and Remarks:

8" @ 201 WOC

RECORD

Cased in., ft.

Sand

Gas

Oil

Total Depth

PRODUCTION

1st 24 hrs. Nat.

1st 24 hrs. after shot

Gas Cu. Ft.

Dry Hole

Abandoned

Date

DEC 1 0 1947 19

S. J. LEWIS

Scout

Map No. 55 Sec. 4 Twp. 16 R. 12W

Well No. 1 Casey

W. L. Hartman Company

CORRECTION

Contractor

NW NE NW


SECTION PLAT

330 Ft. from N. Line

 Ft. from S. Line

990 Ft. from E. Line

 Ft. from W. Line

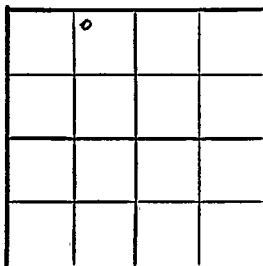

Barton County

Location

Rig up

Drilling and Remarks:

Had spotted
NE NW NW

RECORD

Cased in., ft.

Sand

Gas

Oil

Total Depth

PRODUCTION

1st 24 hrs. Nat.

1st 24 hrs. after shot

Gas Cu. Ft.

Dry Hole

Abandoned

Date

DEC 10 1947 19 S. J. LEWIS Scout

Map No. 55 Sec. 4 Twp. 16 R. 12W

Well No. 1 Casey

W. L. Hartman Company

COMPLETE

Contractor

NW NE NW

51,827

SECTION PLAT

330 Ft. from N. Line

	4		

 Ft. from S. Line

990 Ft. from E. Line

 Ft. from W. Line

Barton County

Location

Rig up

Drilling and Remarks:

CR 8317

5" 8317

Pump 52 Bld

87 1/2

RECORD

Cased in, ft.

Sand

Gas

Oil ✓

Total Depth 2326

PRODUCTION

1st 24 hrs. Nat.

1st 24 hrs. after shot

Gas Cu. Ft.

Dry Hole

Abandoned

Date

MAR 3 1948 S. J. LEWIS Scout